


# T.13 S. R. 31 E. W.M.

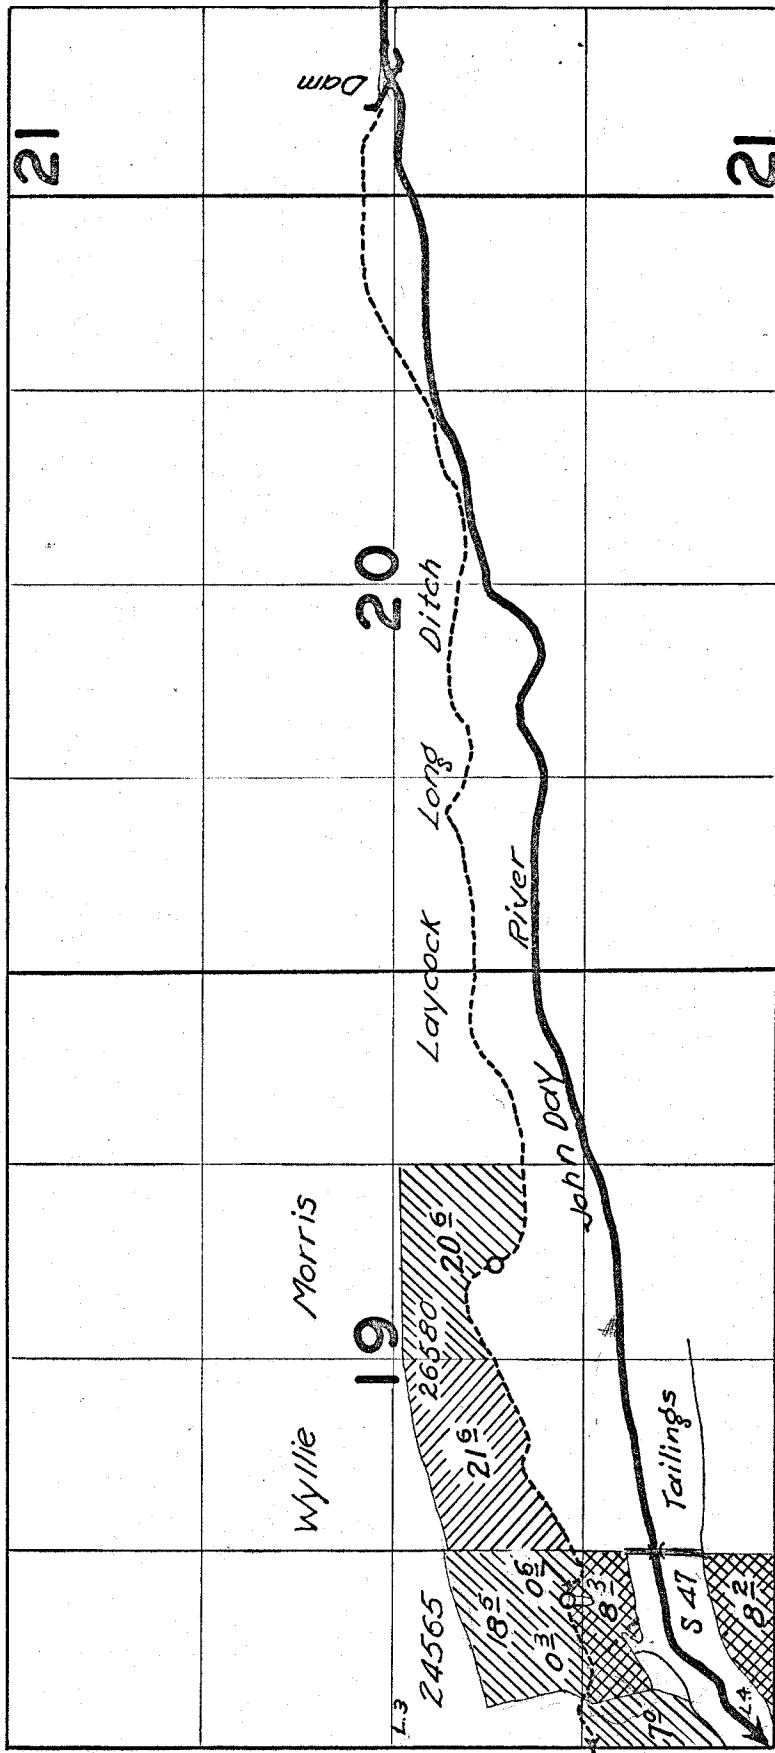

## FINAL PROOF SURVEY

Application No. 26580 Permit No. 20824  
 S-47 19367  
 24565

Name... John Silvers & James A. Wyllie & Clark Morris  
 Surveyed Aug. 27-28, 1954 by H. L. Coffman & T. Jones

G6-28  
 Pantograph