


# T.I.S.R.I.W.W.M

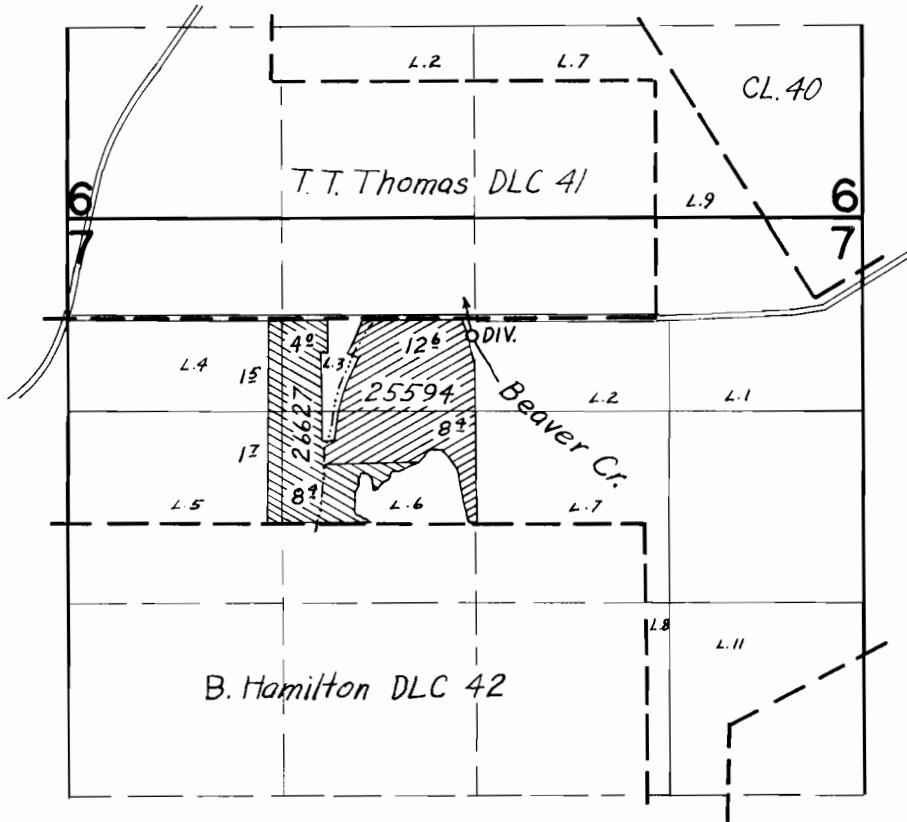

## FINAL PROOF SURVEY

UNDER

Application No. 25594      Permit No. 20084  
 26627      20851

IN NAME OF

Frank Steward

Surveyed July 15 19 54, by H. L. Coffman.