


T.10 S. R. 1 W. W. M

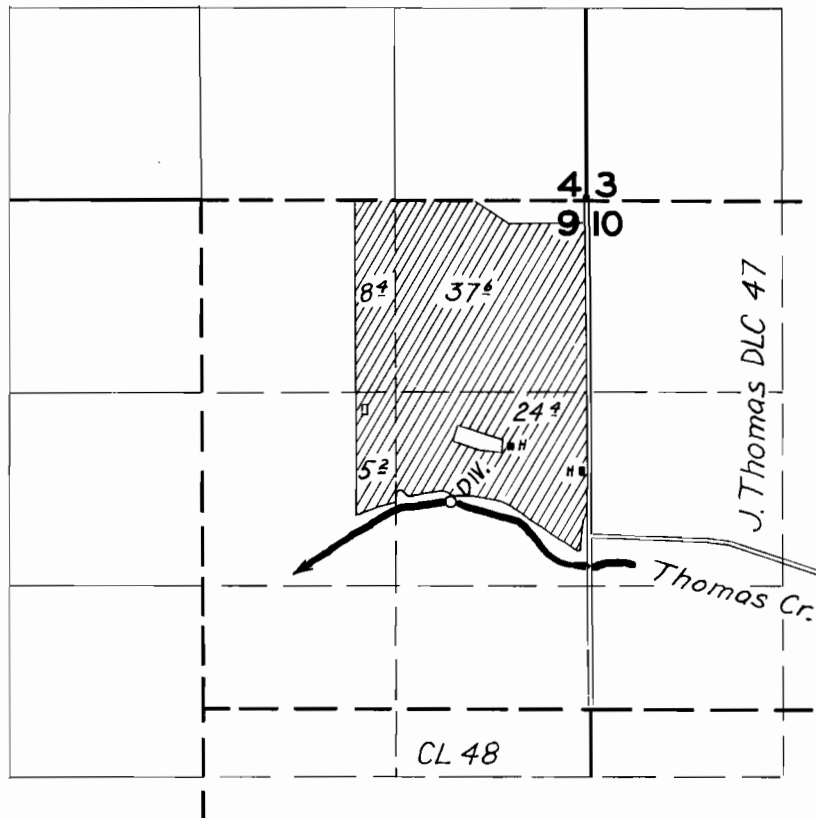

FINAL PROOF SURVEY

UNDER

Application No. 26631 Permit No. 20863

IN NAME OF

Carol W. Crenshaw and Sylva E. Crenshaw

Surveyed July 9 19 54, by H. L. Coffman