# T.10S.R1W. WM

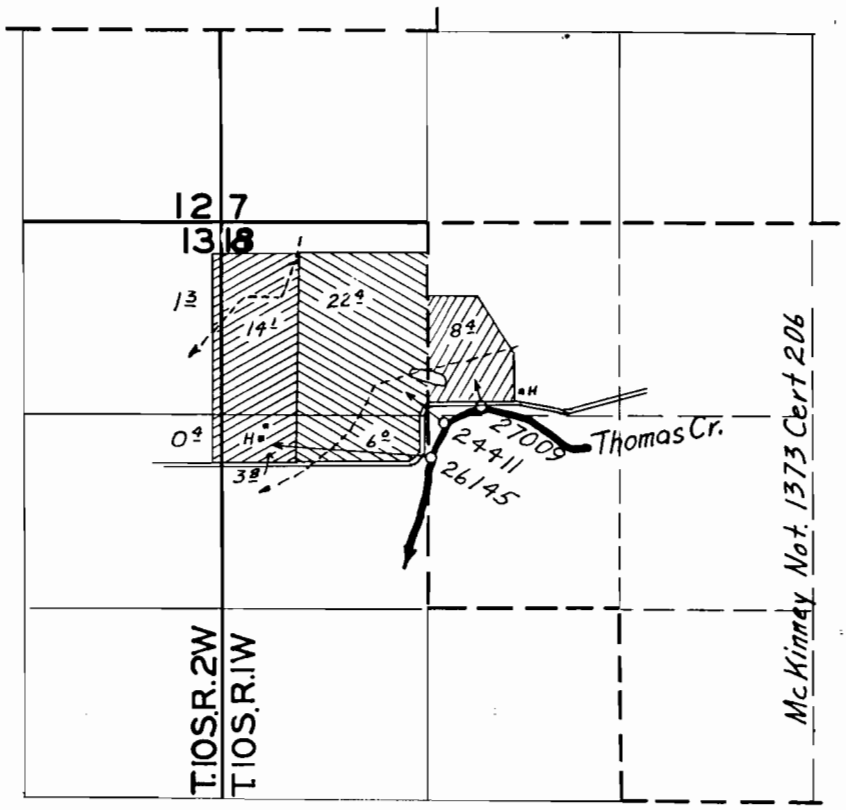


## FINAL PROOF SURVEY

27009 21213
24411 19453
Application No. 26145 Permit No. 20991

Hans Peterson
Ernest Scott, Jr.
Samuel J. Burdick

Surveyed July 8 19 54, by L. Coffman.

DFM-2D-180