


T.10S.R.1W.WM

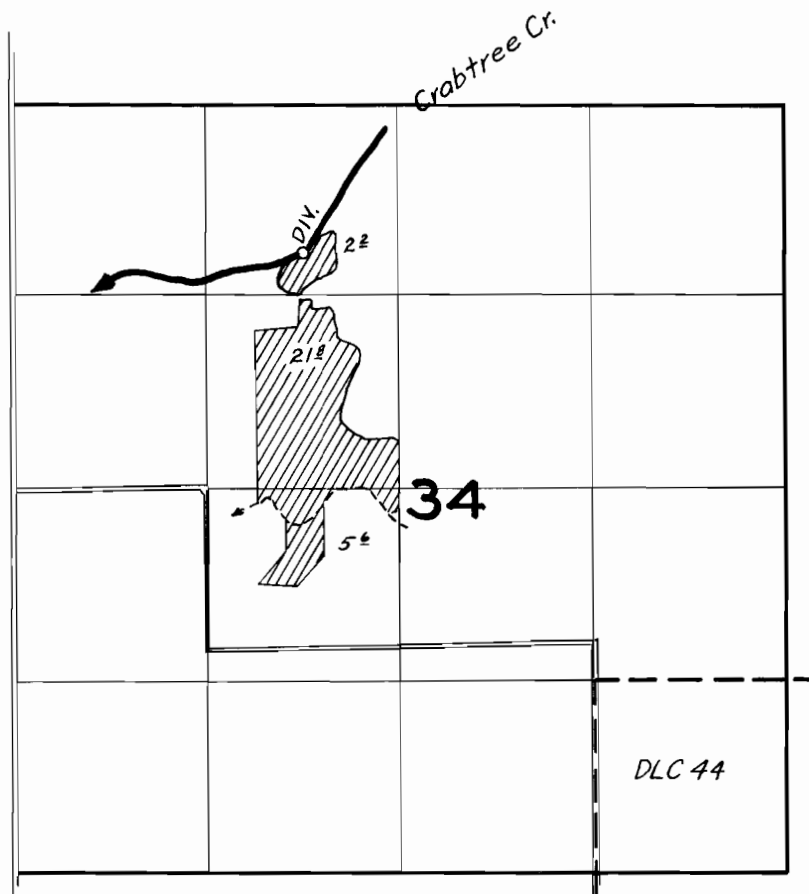

FINAL PROOF SURVEY UNDER

Application No. 26909 Permit No. 21114

IN NAME OF

James and Emma L. Oupor

Surveyed July 12 1954, by H. L. Coffman