


T.10S.R.1W. WM

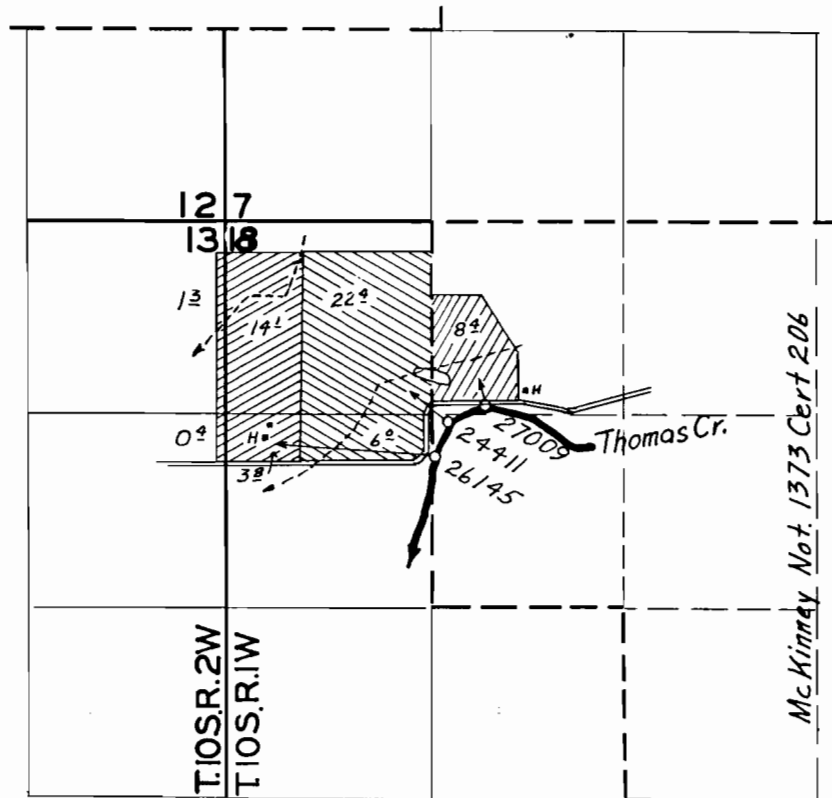

FINAL PROOF SURVEY

27009 21213
 24411 19453
 Application No. 26145 Permit No. 20991
 Hans Peterson
 Ernest Scott, Jr.
 Samuel J. Sundick

Surveyed July 8 19 54, by L. Coffman.