


T. 10S. R. 1 W. WM

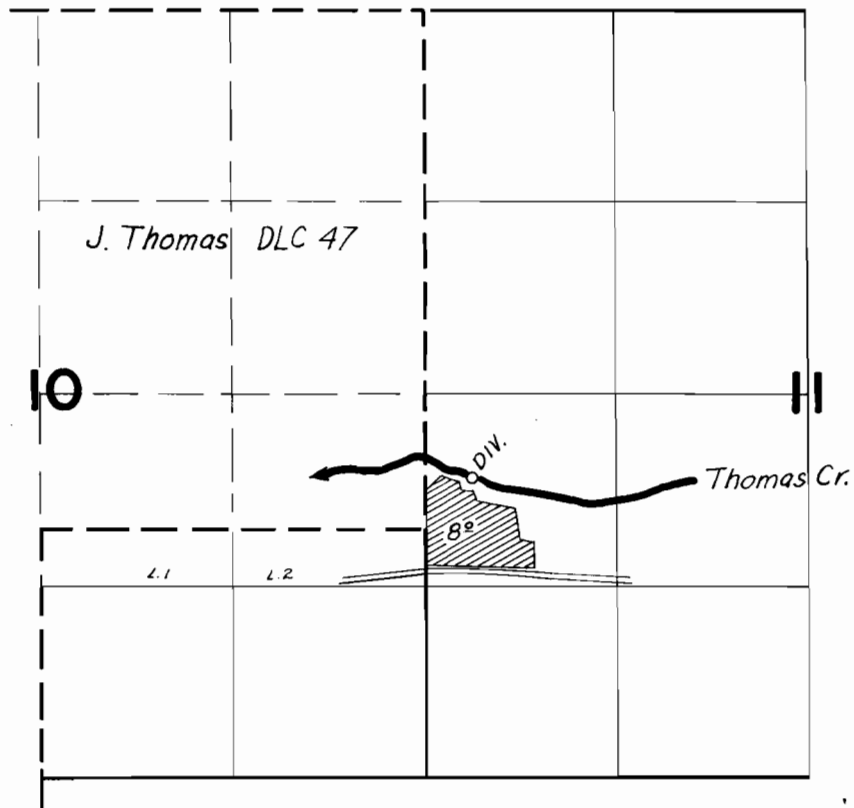

FINAL PROOF SURVEY

UNDER

Application No. 27099 Permit No. 21324

IN NAME OF

Anton Rosprafka or Vincie Rosprafka

Surveyed July 8 19 54, by H. L. Coffman

DFM-1B-53