


T.10S.R.2W.WM

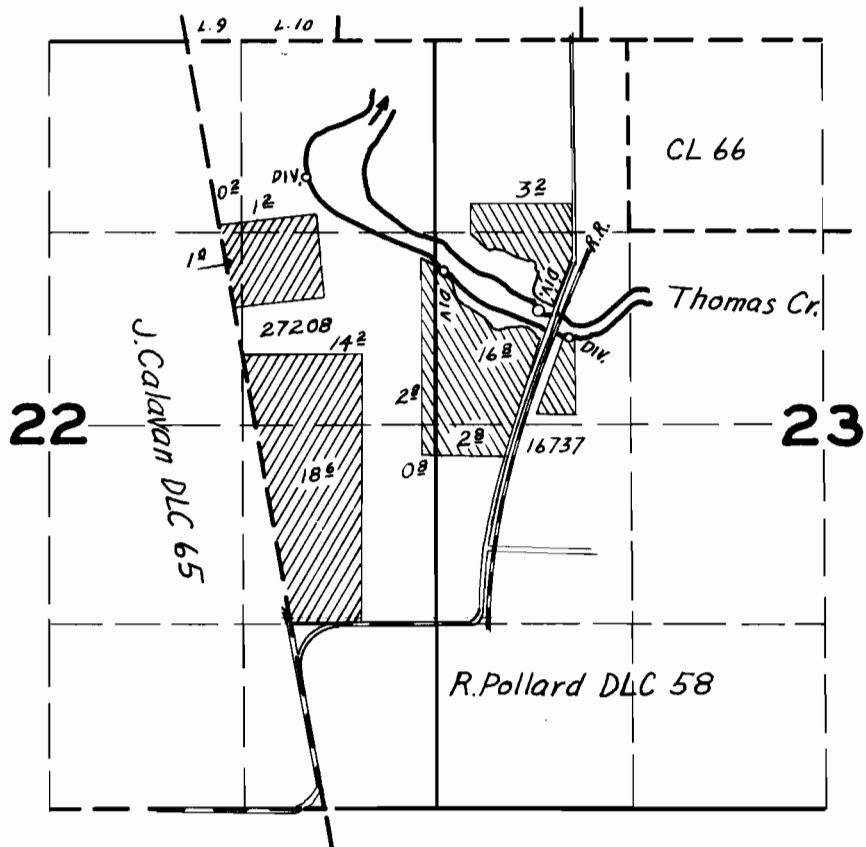

FINAL PROOF SURVEY

UNDER

Application No. 27208 ... Permit No. 21393
16737 ... 12520

IN NAME OF

E. W. Hart
W. A. Gilkey

Surveyed July 6-7-19 54, by H. L. Coffman.