


T.17S. R.8W.W.M.

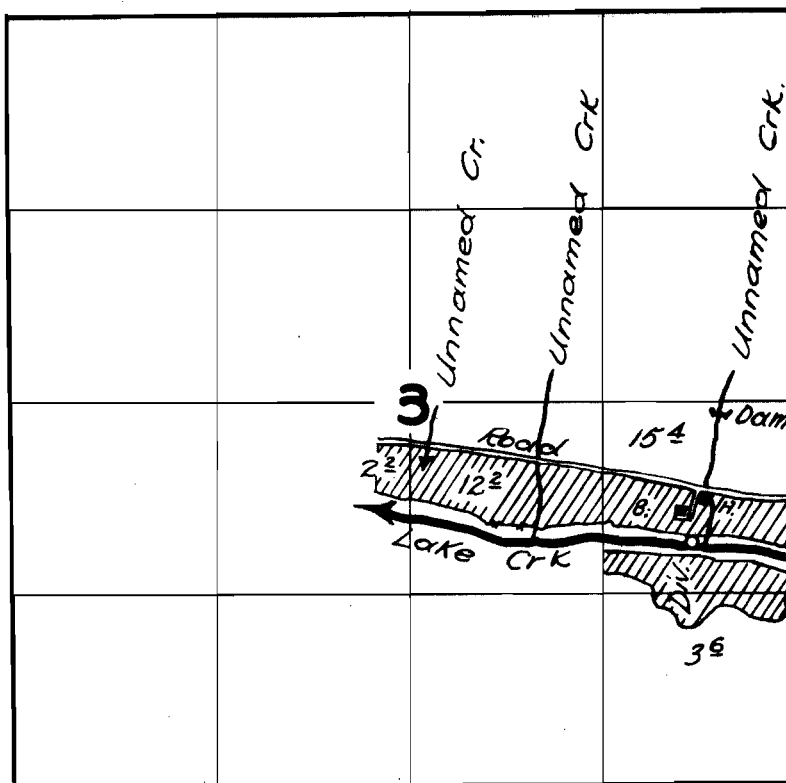

FINAL PROOF SURVEY
UNDER

Application No. 26900..... Permit No. 21513.....
IN NAME OF

.....Alfred Steinhauer.....

Surveyed Aug. 13, 1954, by H. L. Coffman