


T.16S.R.47E.W.M.

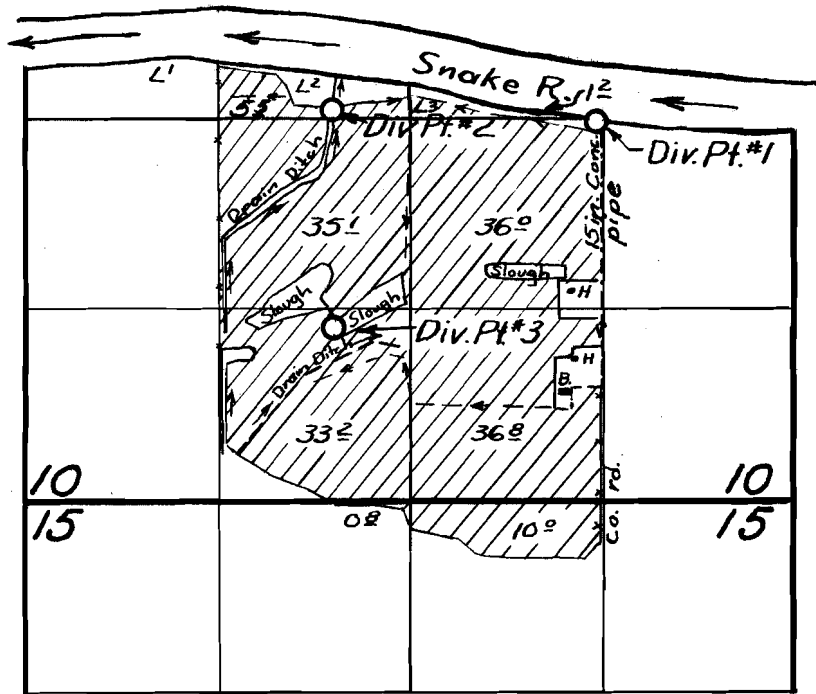

**FINAL PROOF SURVEY**

UNDER

Application No. 27547 Permit No. 21698

IN NAME OF

*Peter Petersen*

Surveyed *Oct. 11 & 12* 1955, by *T. M. Gish*