


T.10S.R.1W.WM

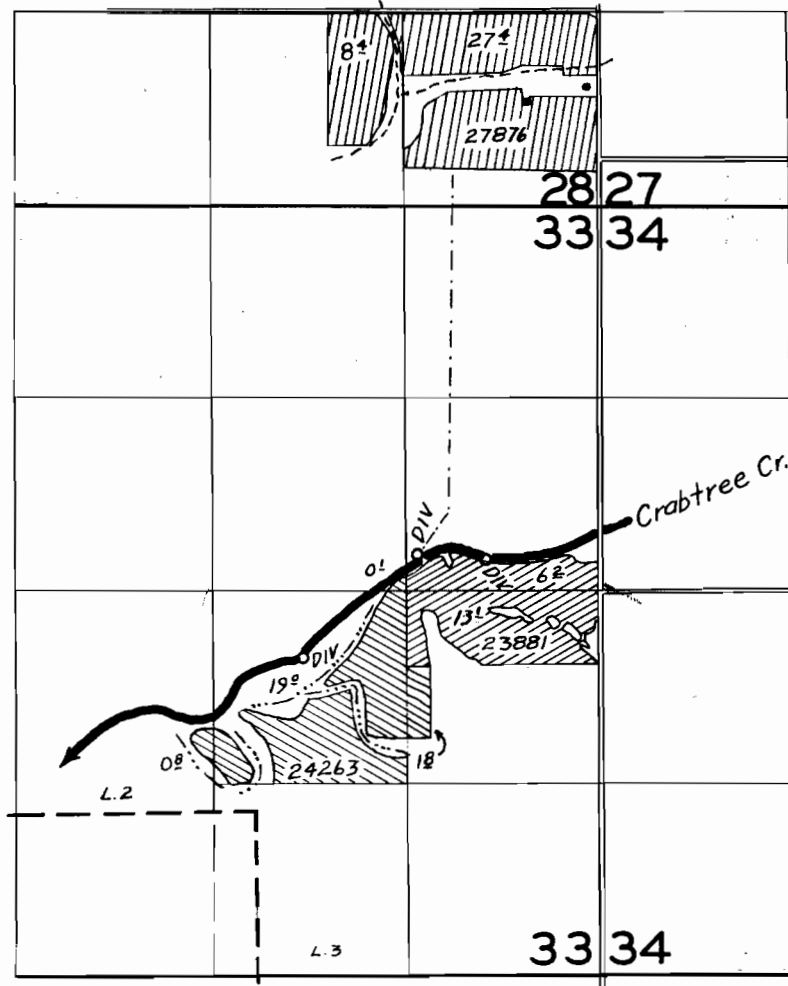

FINAL PROOF SURVEY

24263 19215
 23881 18797
 Application No. 27876 Permit No. 21963

Ollin L. Wood
 Geo. H. and Lena Truman
 Jin & Helena Krosman

Surveyed July 12 1954, by H. L. Coffman