


T.18S.R.1W.WM

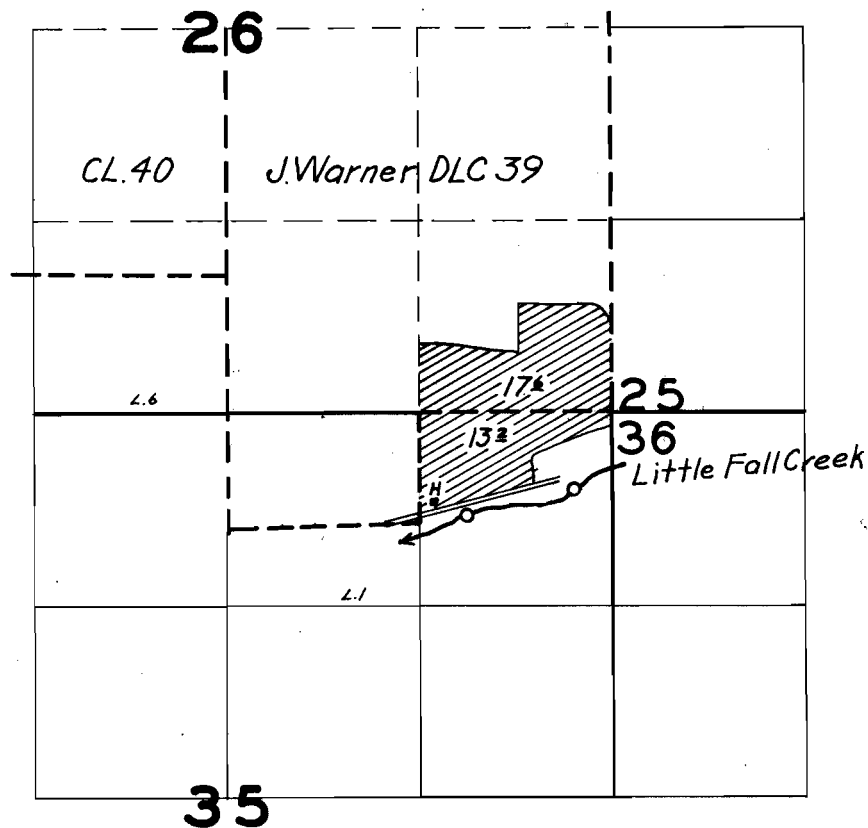

FINAL PROOF SURVEY UNDER

Application No. 21777 Permit No. 21818
IN NAME OF

Kenneth LaFon

Surveyed April 22 1954, by T. Jones