


# T.30S.R.5W.W.M.

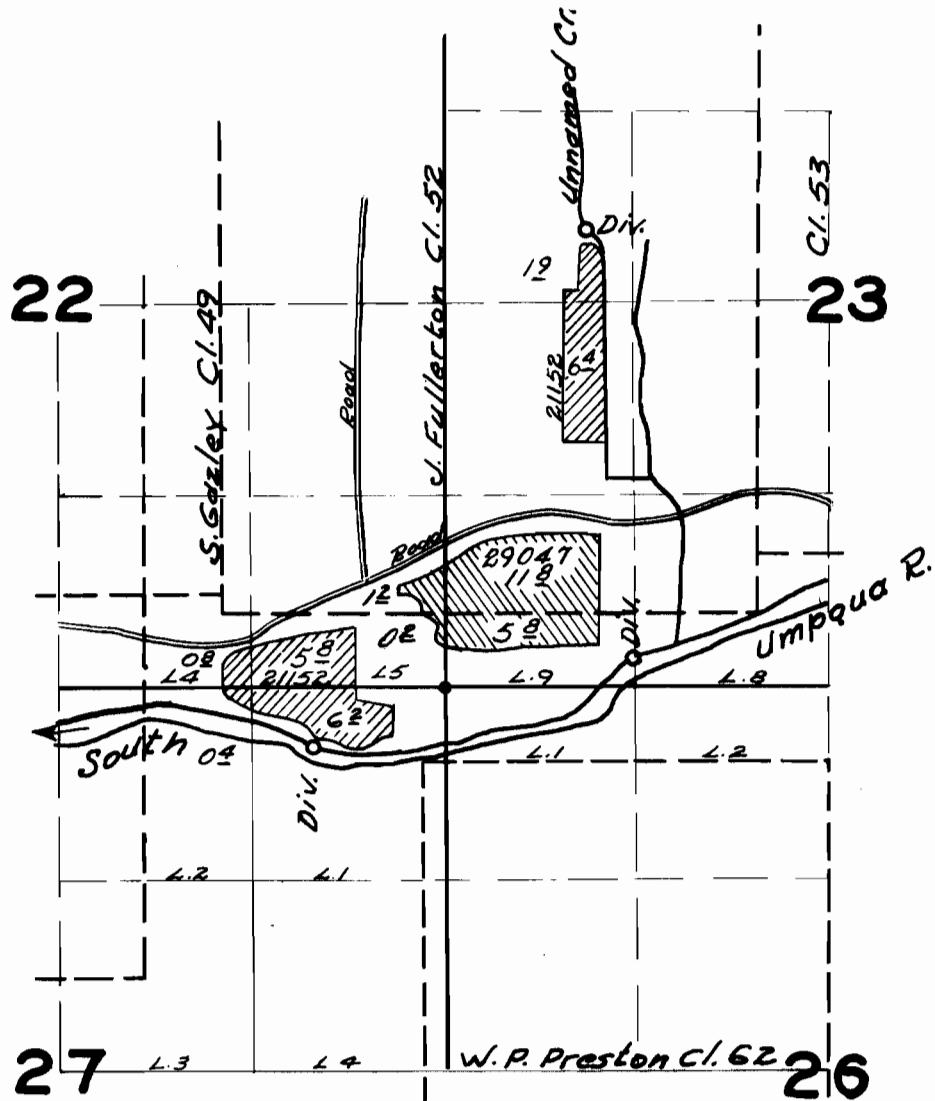

## FINAL PROOF SURVEY

UNDER

29047

22848

Application No. 21152 Permit No. 17513

IN NAME OF

Ermel Biggs

Surveyed July 23 1954, by H. L. Coffman