



2

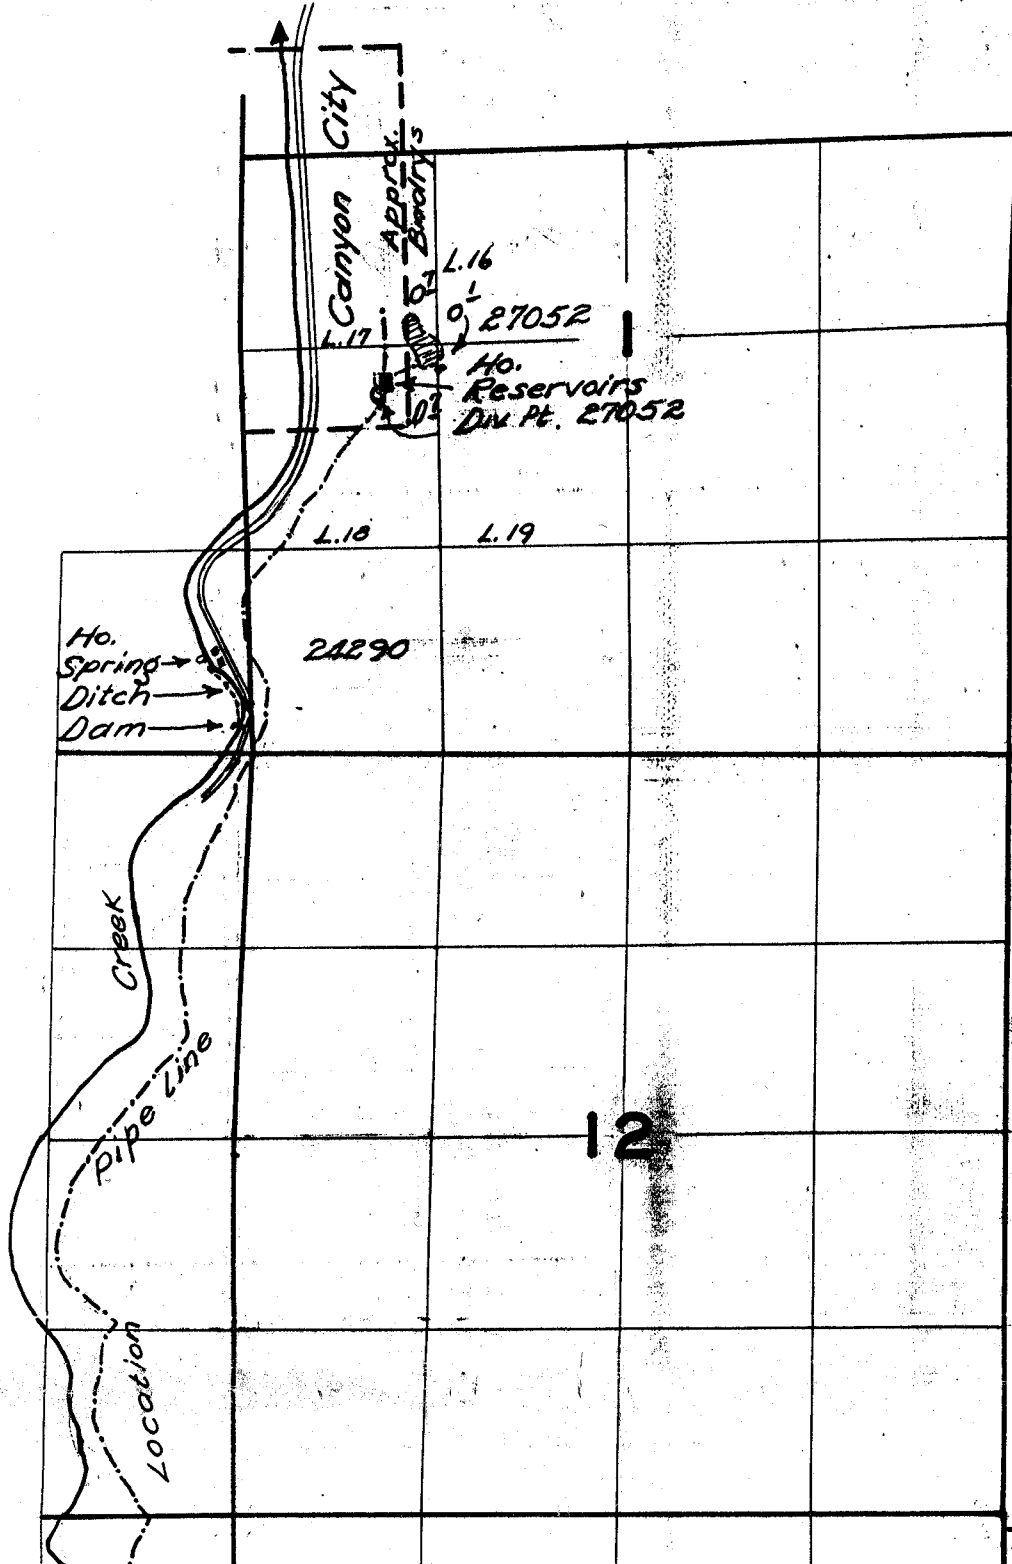

11

12

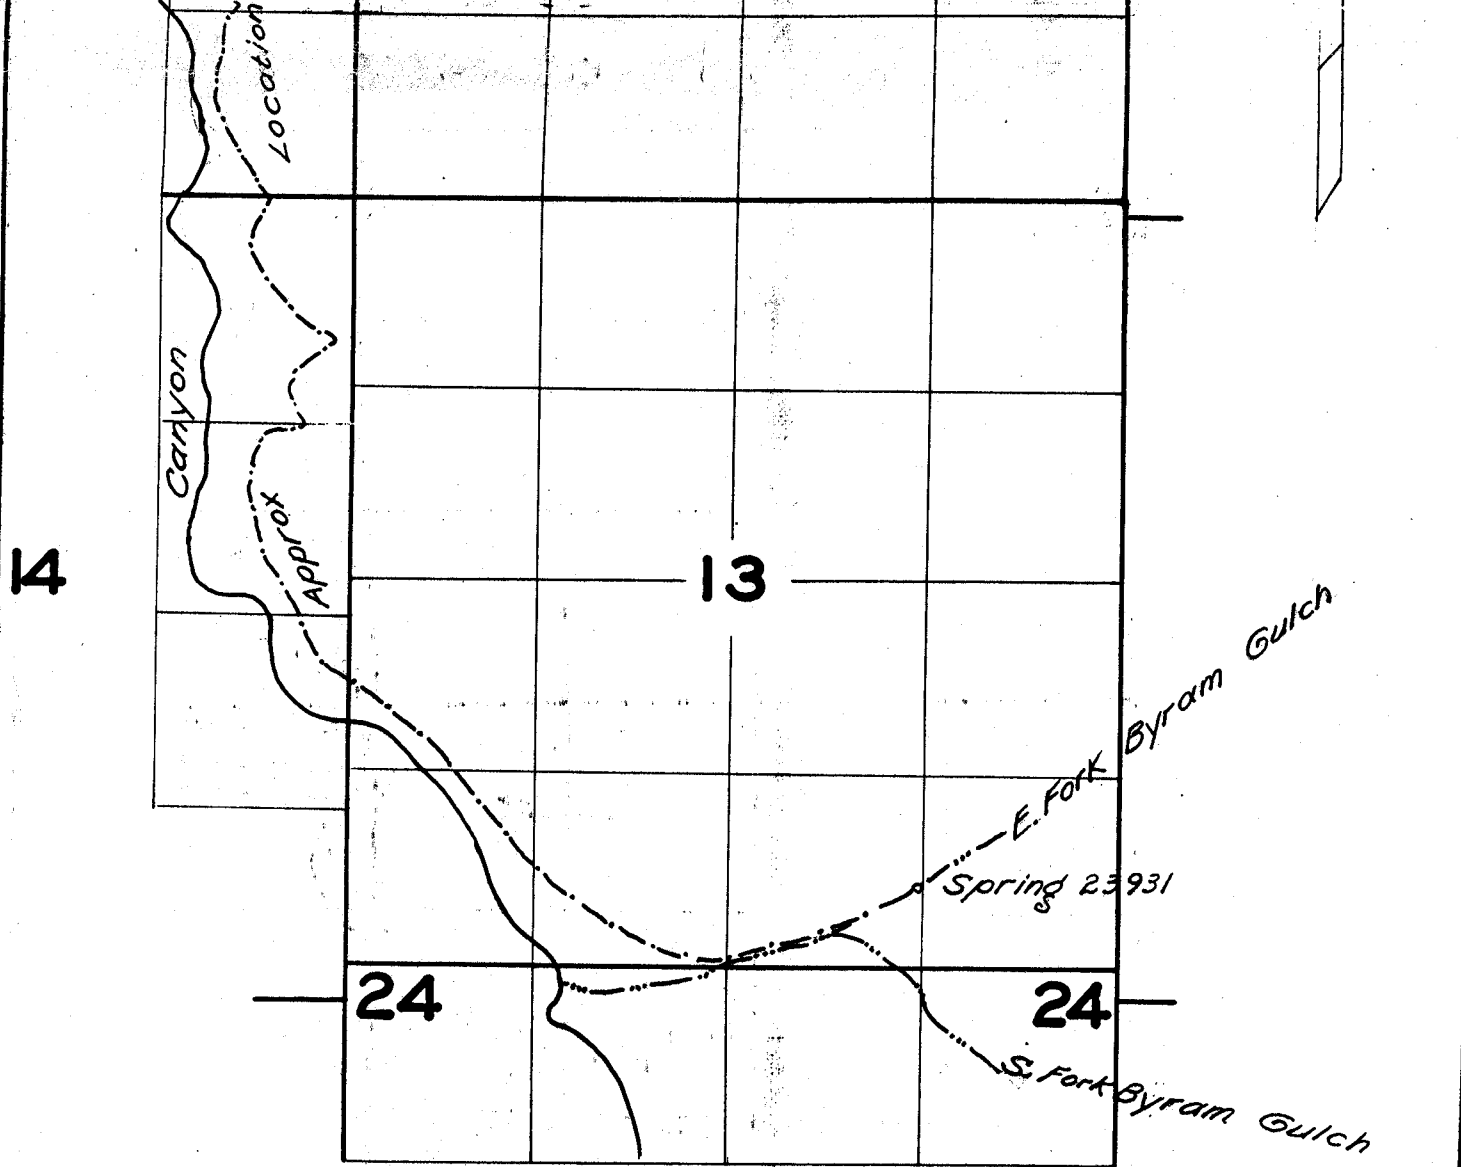

FINAL PROOF SURVEY

Con M. Medina	Appl. No. 24290	Permit No. 19120
Roy Kilpatrick	27052	21516
City of Canyon City	23931	18845

Surveyed Sept. 1-2, 1954 by H. L. Coffman

G7-31

P- 19120