


T.7S.R.5W.WM

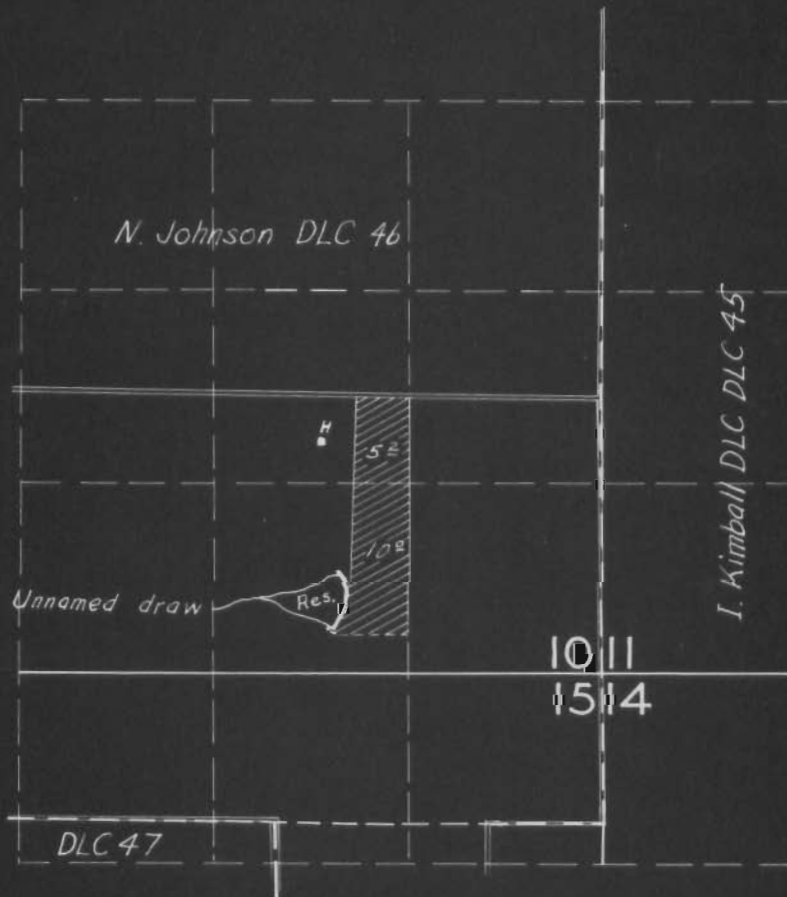

FINAL PROOF SURVEY

UNDER

24268

20955

Application No. E-24267 Permit No. E-1296

IN NAME OF

James Copp

Surveyed Aug. 19 19 54 by T. Jones