


T.14S.R.31E.W.M.

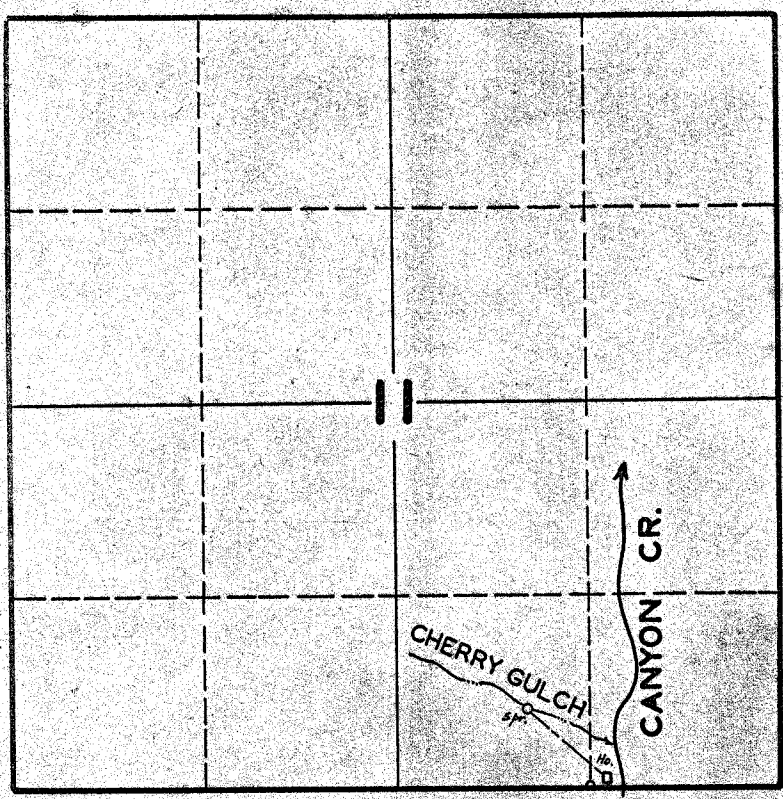

FINAL PROOF SURVEY UNDER

Application No. 17695 Permit No. 13383

IN NAME OF

W.G. & BESSIE P. ST. MARIE

Surveyed APR. 26. 1946. by *[Signature]*