


# T.I.S.R.2 W.W.M.

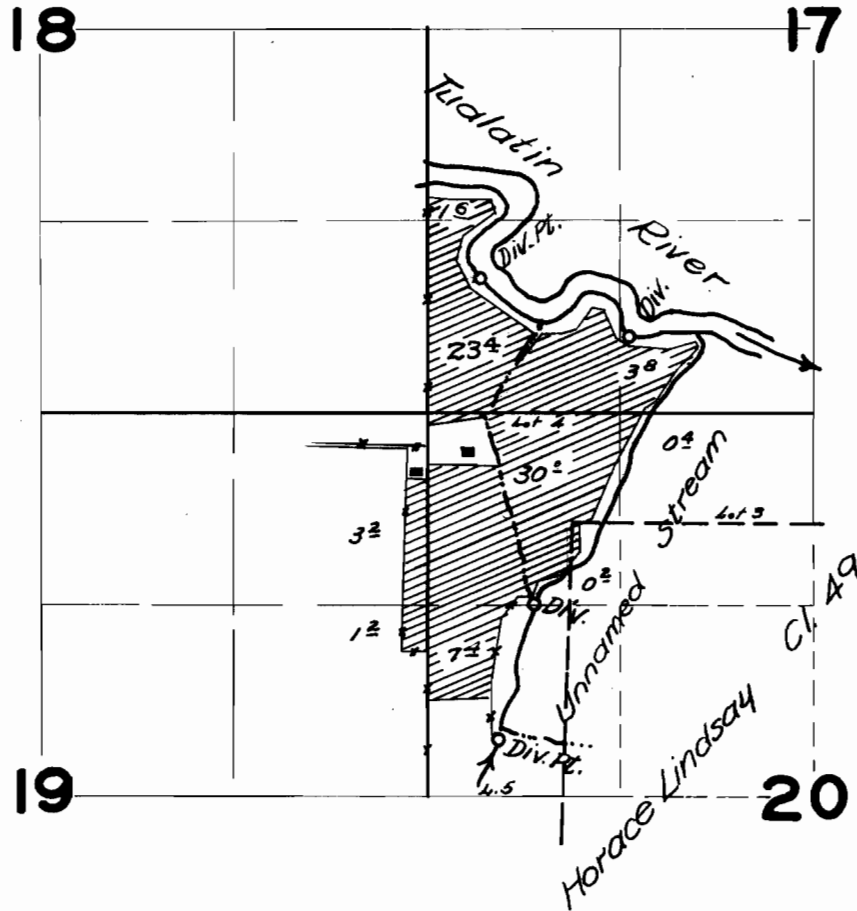

## FINAL PROOF SURVEY

UNDER

Application No. 18993 Permit No. 14609

IN NAME OF

J. E. BUCKLEY

Surveyed July 11, 1951, by H. L. COFFMAN

Call  
21349