


T. 17S. R. 6 W.W.M.

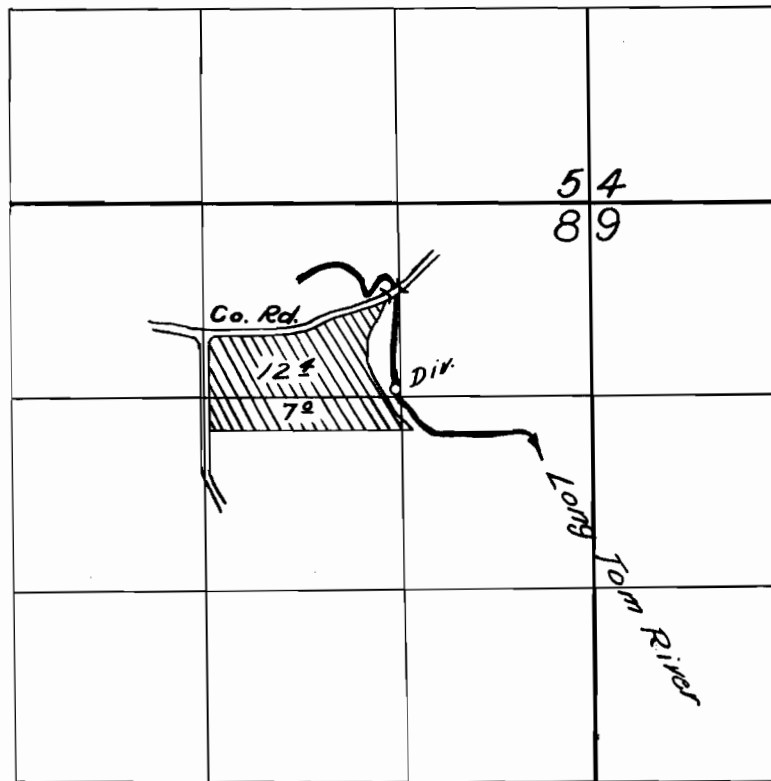

FINAL PROOF SURVEY

UNDER

Application No. 19707... Permit No. 15284

IN NAME OF

W. H. & Alma Benoit

Surveyed ^{May 11} April 27 1954, by H.L. Coffman