


T. 8 S., R. 4 W., W.M.

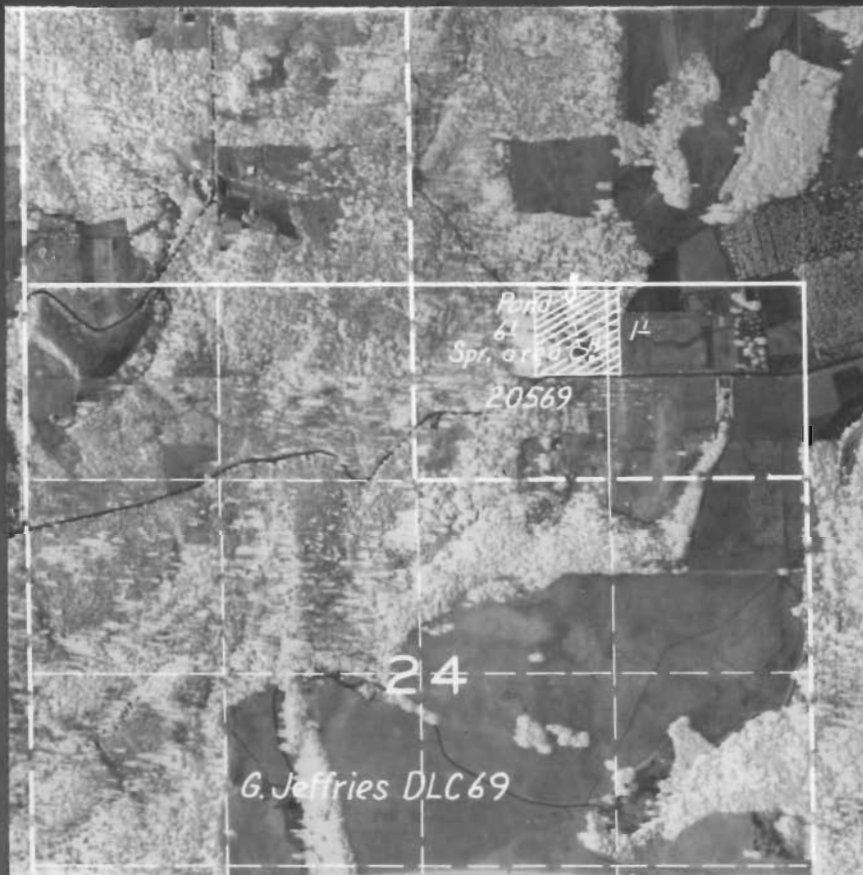

FINAL PROOF SURVEY
UNDER

Application No. 20569 Permit No. 16117
IN NAME OF

A. W. Smither

Surveyed April 16 1954, by T. Jones