


T.28S.R.7WWM

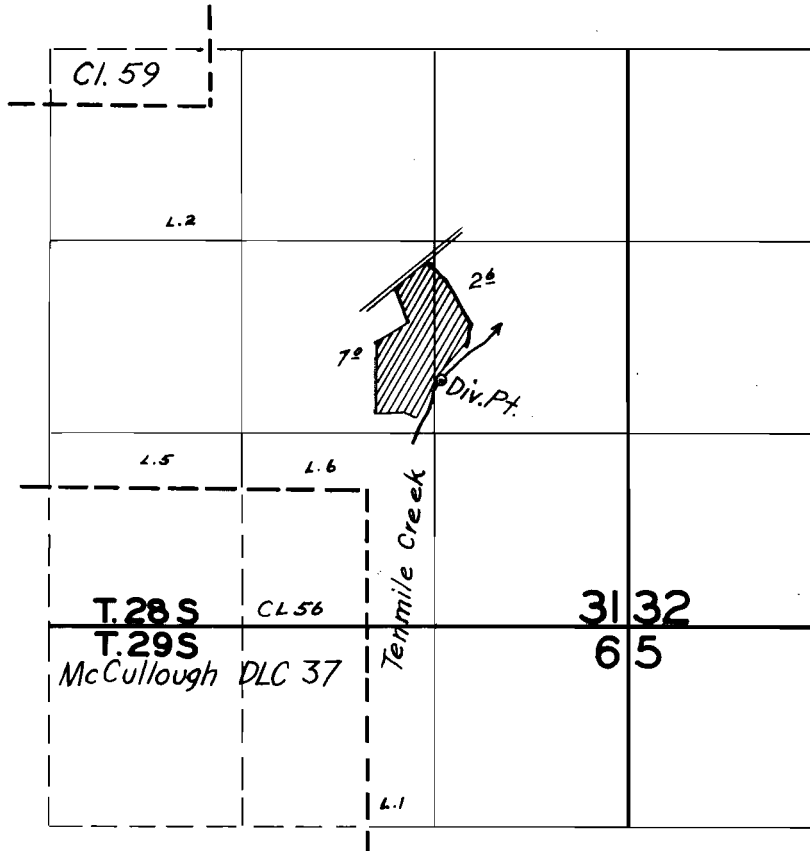

FINAL PROOF SURVEY UNDER

Application No. 21532 Permit No. 16886
IN NAME OF

Ben K. Hammond, Ernest T. Schosro

Surveyed July 23, 1954, by T. Jones