


SECTION

TOWNSHIP 5 S, RANGE 3 E, W. M.

North

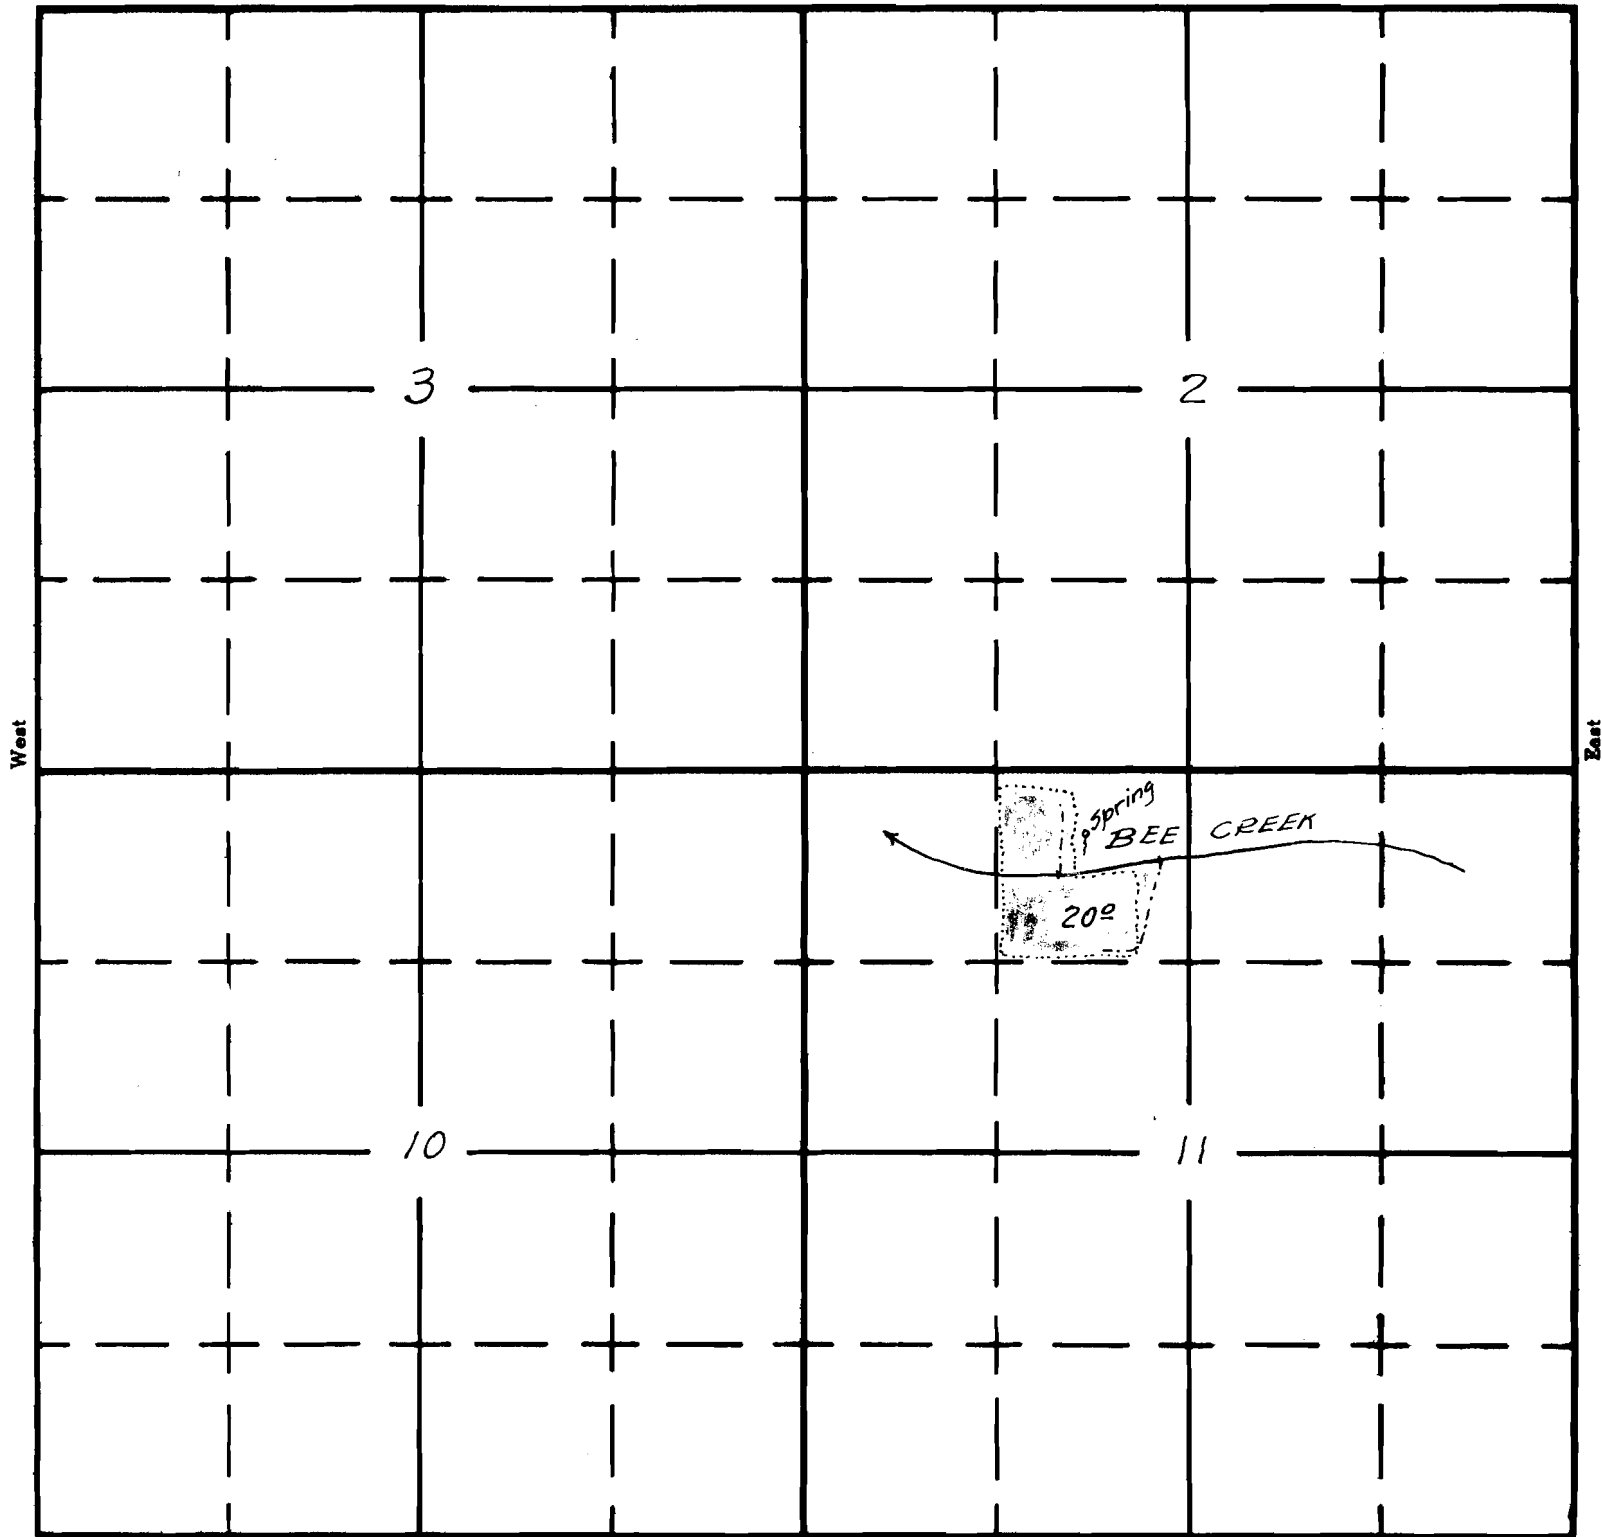

South

SKETCHED IN THE OFFICE
OF THE STATE ENGINEER
FROM DATA BY APPLICANT
5-10-46 EKH

21544 21544
APPLICATION No. 21544
PERMIT No. 10988