


T17 S., R. 6 W., W.M.

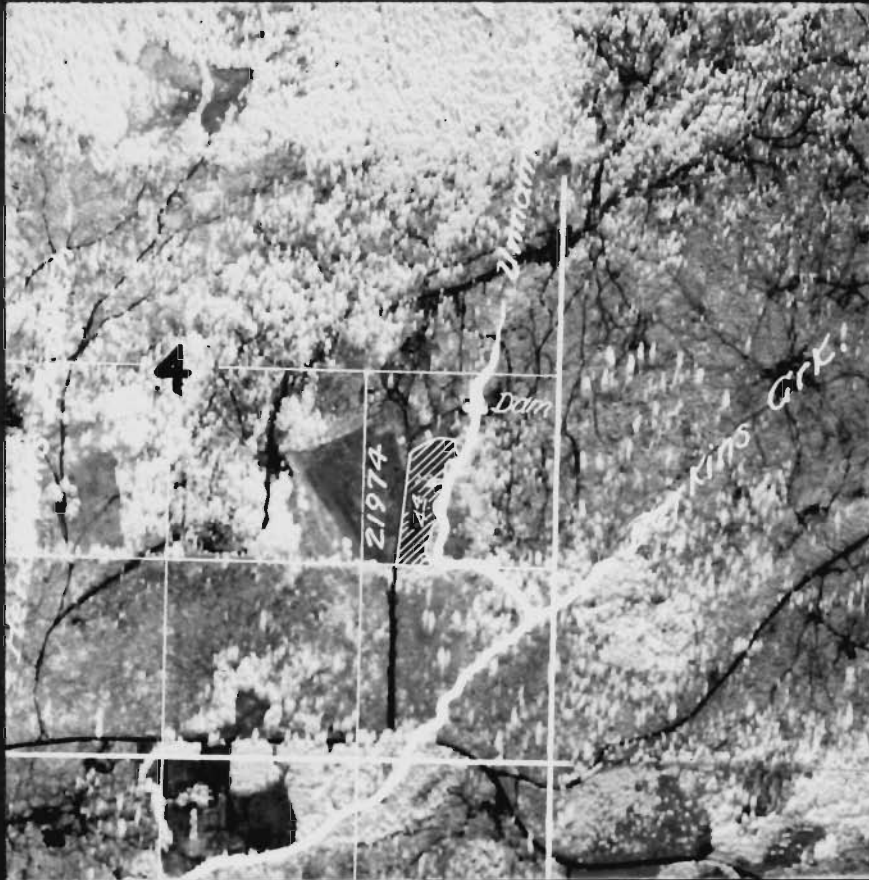

FINAL PROOF SURVEY
UNDER

Application No. 21974 Permit No. 17280
IN NAME OF

Jack Riensche

Surveyed April 27 1954, by H. L. Coffman

DD-311-94