


T28SR12WWM

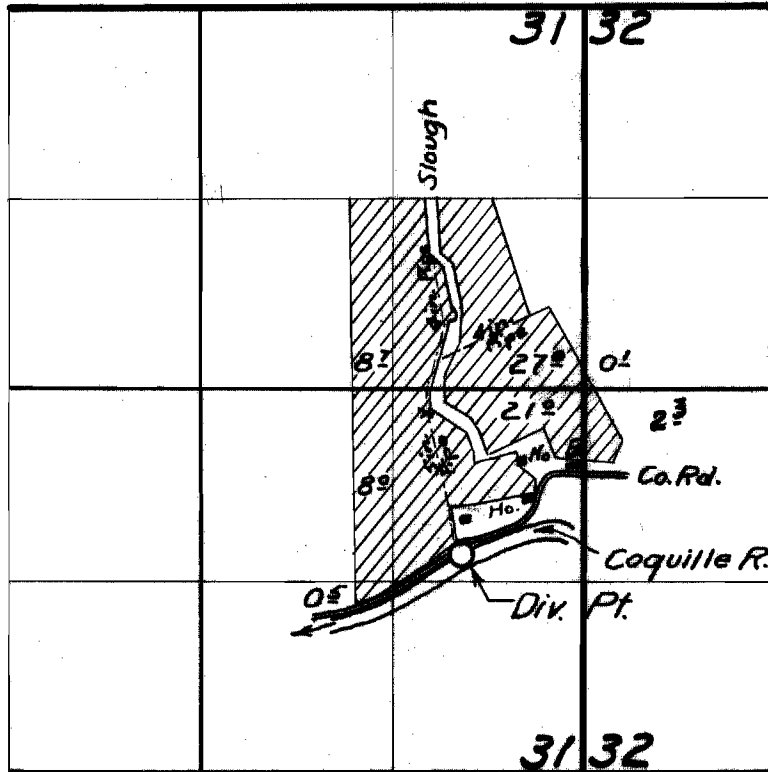

FINAL PROOF SURVEY

UNDER

Application No. 22617 Permit No. 17787

IN NAME OF

J. H. McCLOSKEY

Surveyed Aug 8 1955, by M. B. Rich