


T.29S.R.8 W.WM

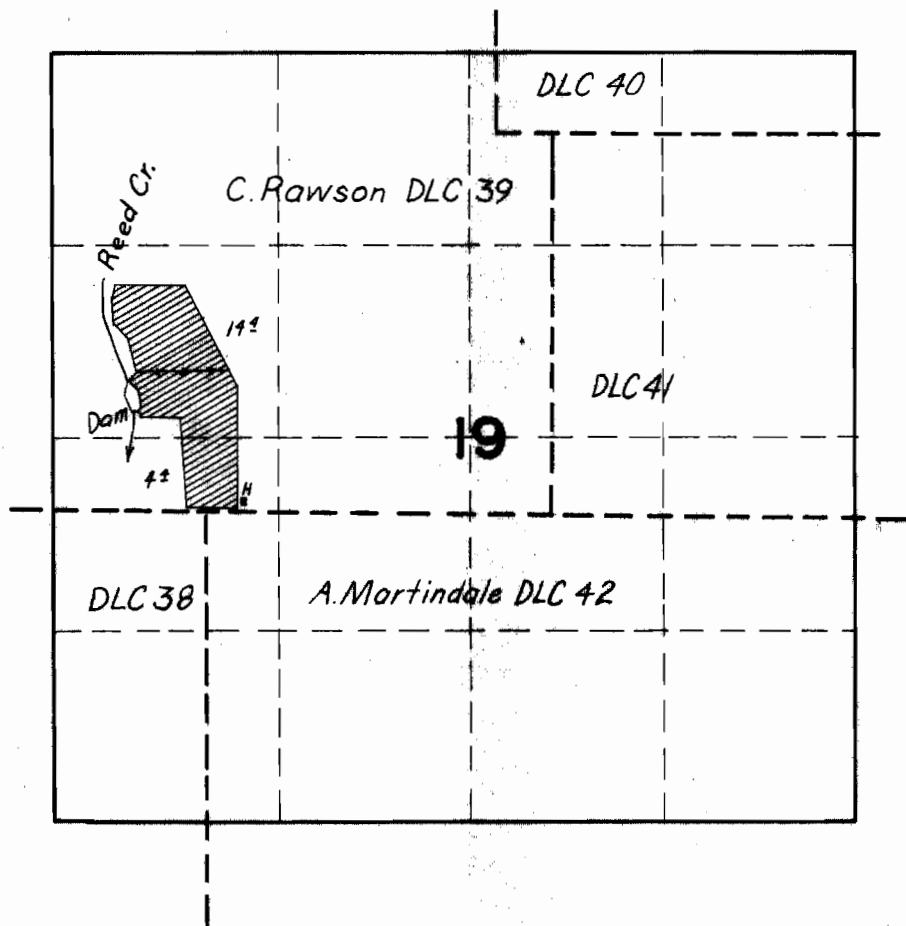

FINAL PROOF SURVEY UNDER

Application No. 23004 Permit No. 18103
IN NAME OF

Ernest H. Wheeler

Surveyed July 22, 1954, by T. Jones