


U-213  
U-239  
16894  
18164

T. R. W.M.

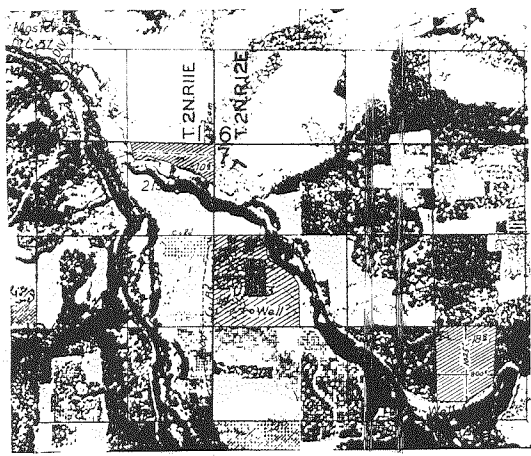

### FINAL PROOF SURVEY

...

Surveyed ... 19 ... by ...