


T.6N.R.35E. W.M.

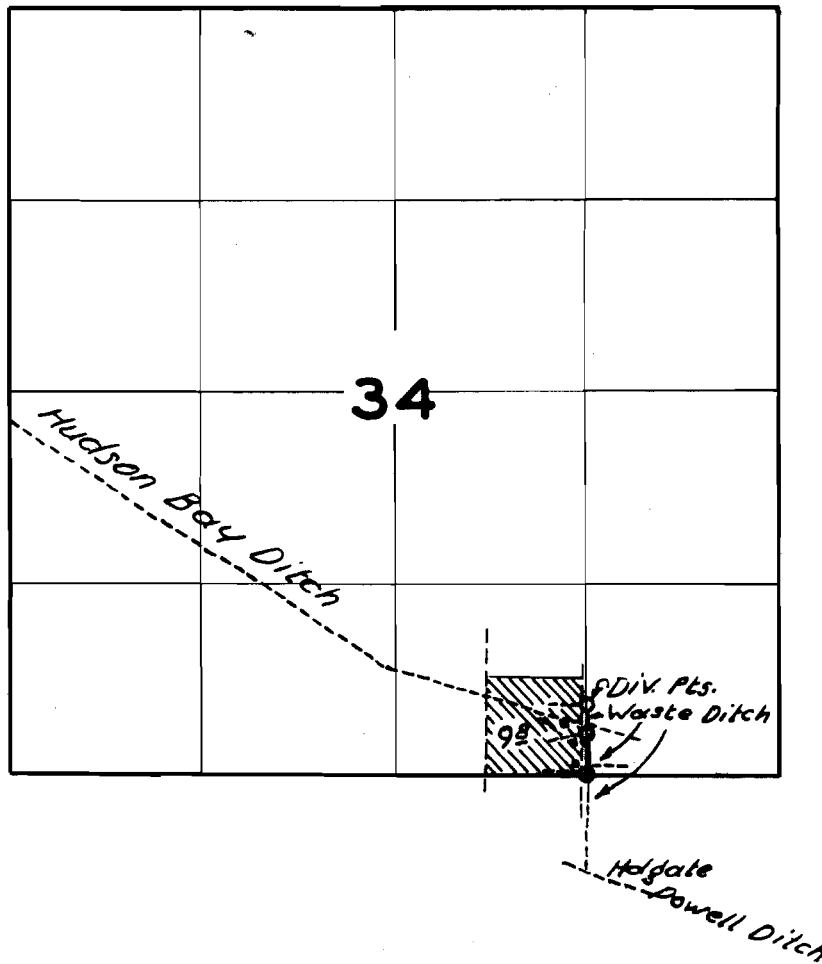

FINAL PROOF SURVEY
UNDER

Application No. 16915..... Permit No. 18673.....
IN NAME OF

..... P. S. Gibbons, Sr.

Surveyed May 17 19 54, by H. L. Coffman