
T. 17 S., R. 1 W., W.M.

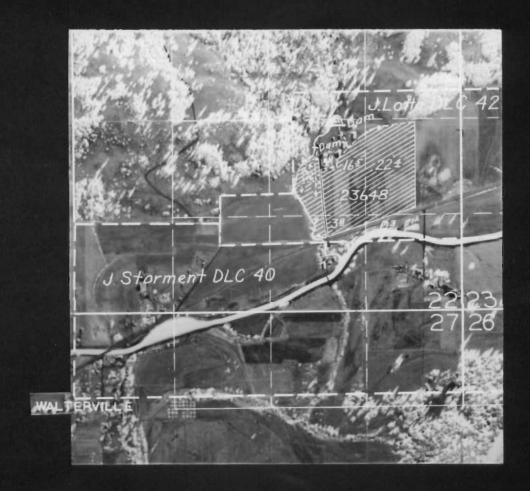

FINAL PROOF SURVEY

UNDER

Application No. 23648 Permit No. 18696 IN NAME OF

Mrs. Ada B. Millican

Surveyed April 261954 , by T. Jones

DB0_3H_33