


T.I.S.R.I.W.W.M

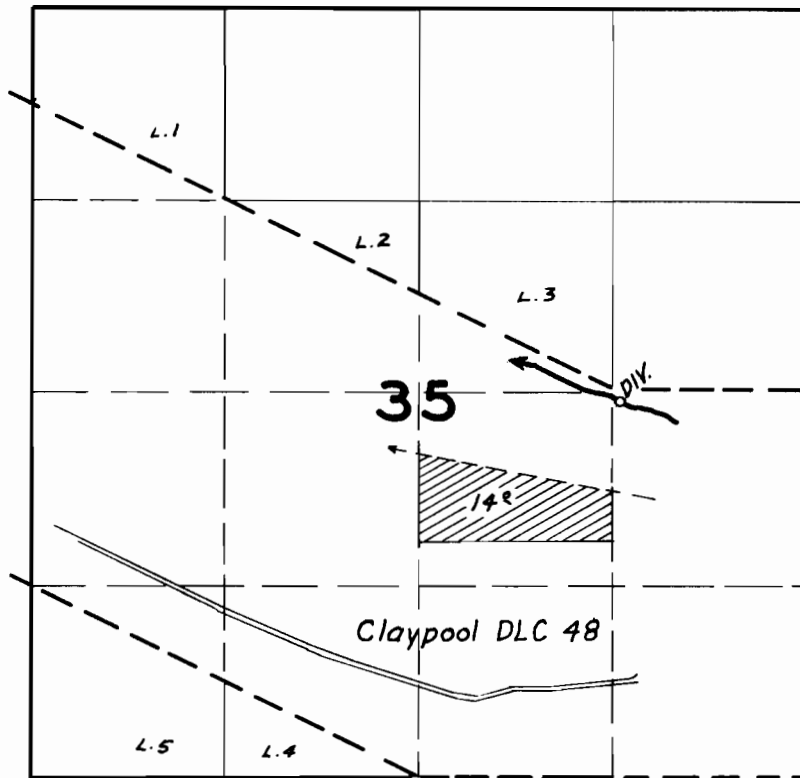

FINAL PROOF SURVEY

UNDER

Application No. 23926 Permit No. 18843

IN NAME OF

Jonathan Crockett

Surveyed July 16 1954, by H. L. Coffman