


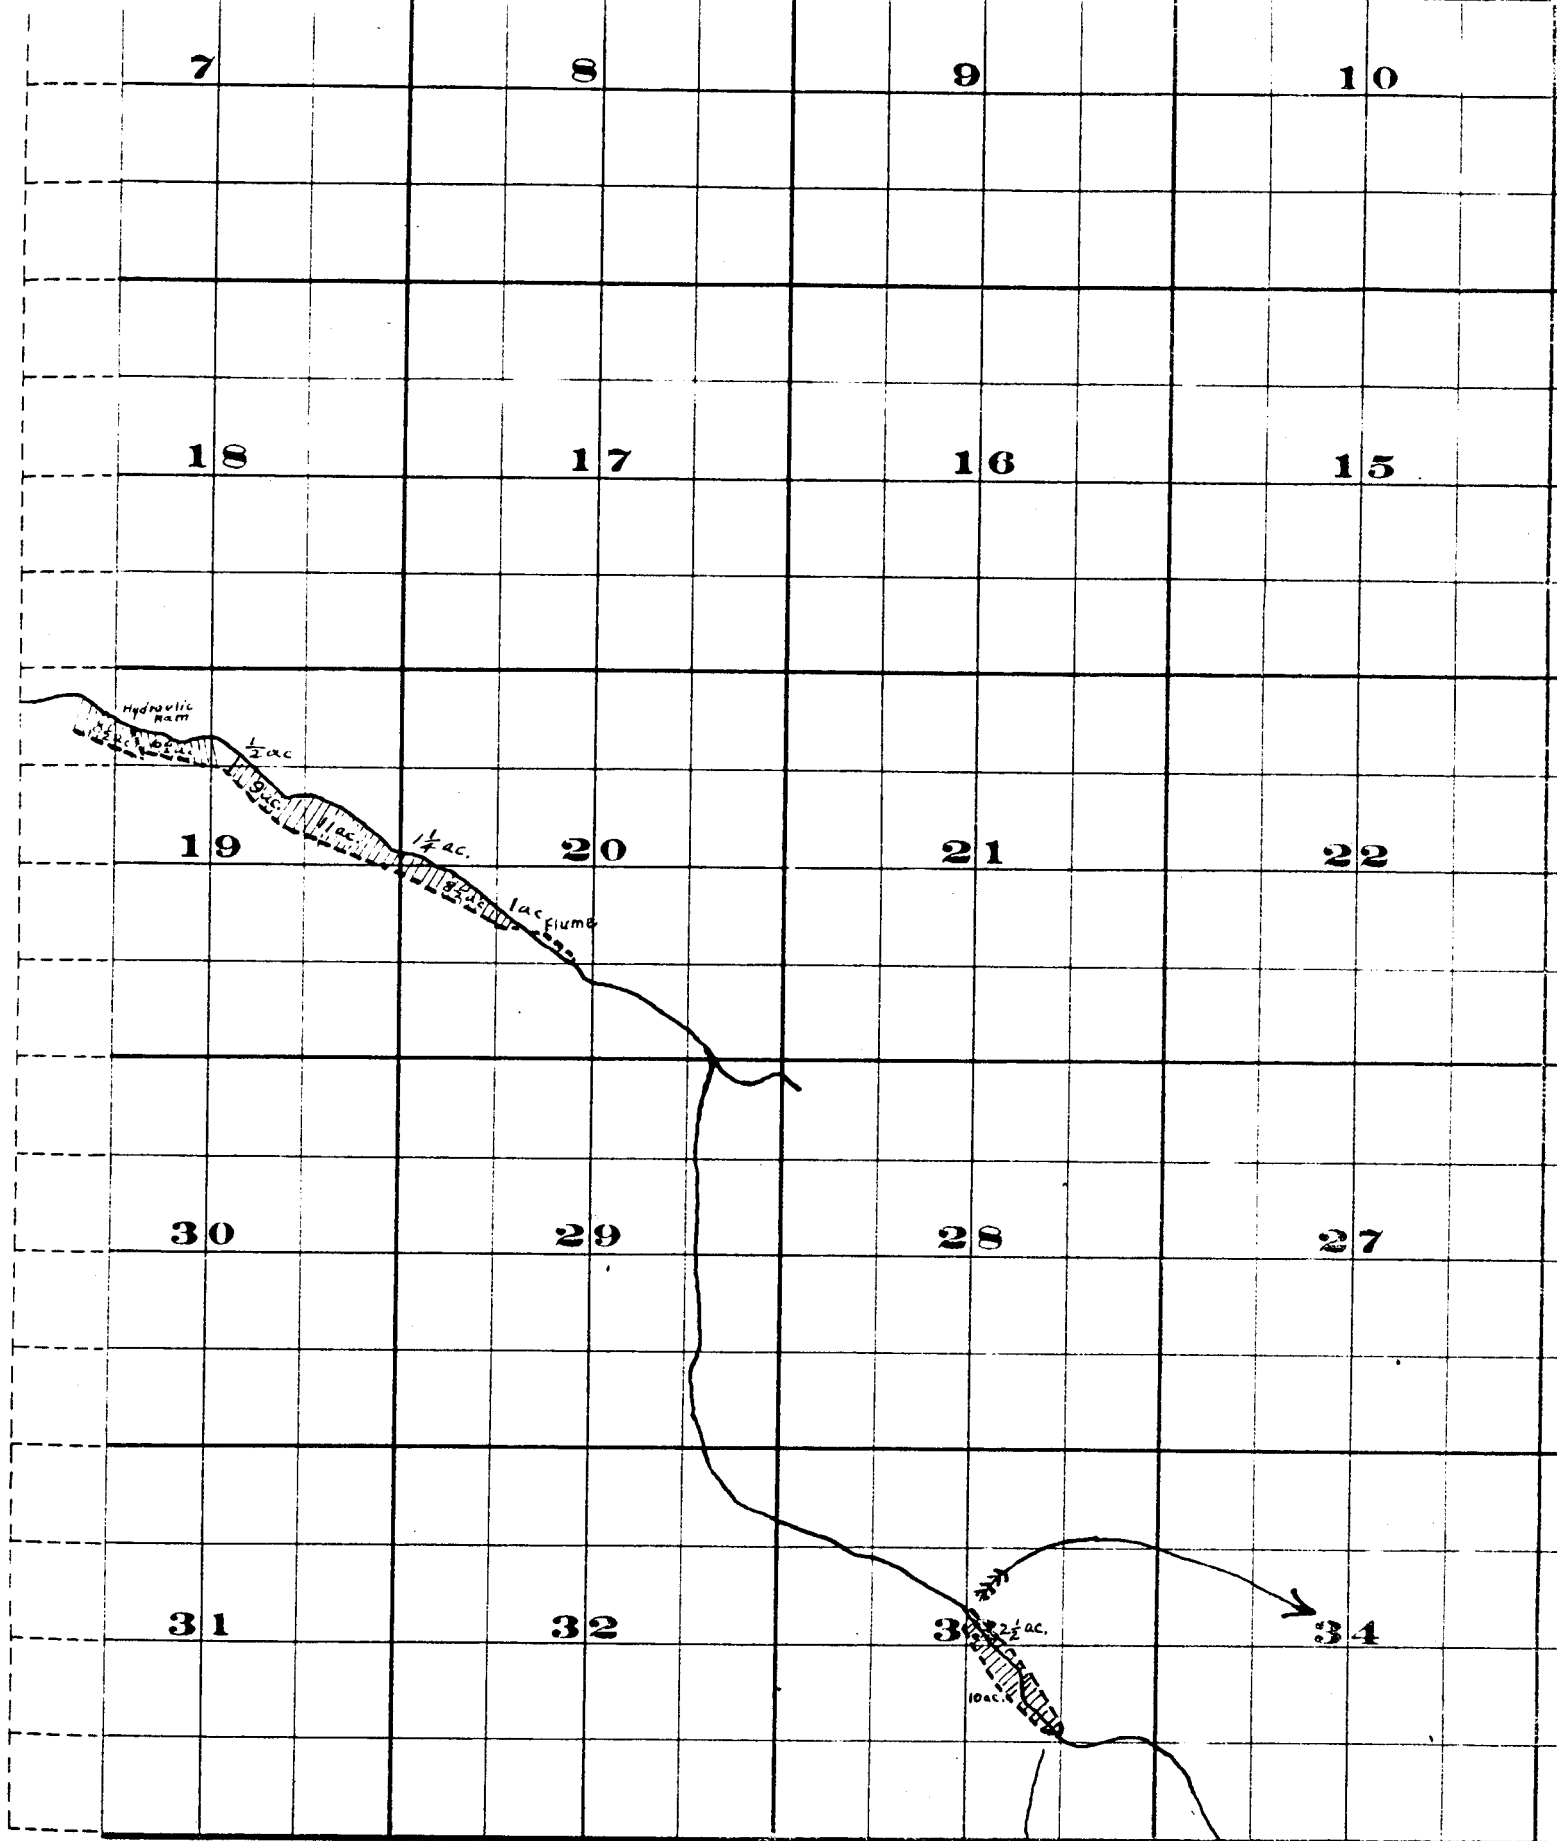


THE S. B. SIOU CO., PRINTERS & BOOK BOUNDERS, LANSING, MICH.

Surveyed by H. K. Donnelly July 1909

John H. Lewis - State Engineer

Examined July 14, 1909.

Township 4 S.

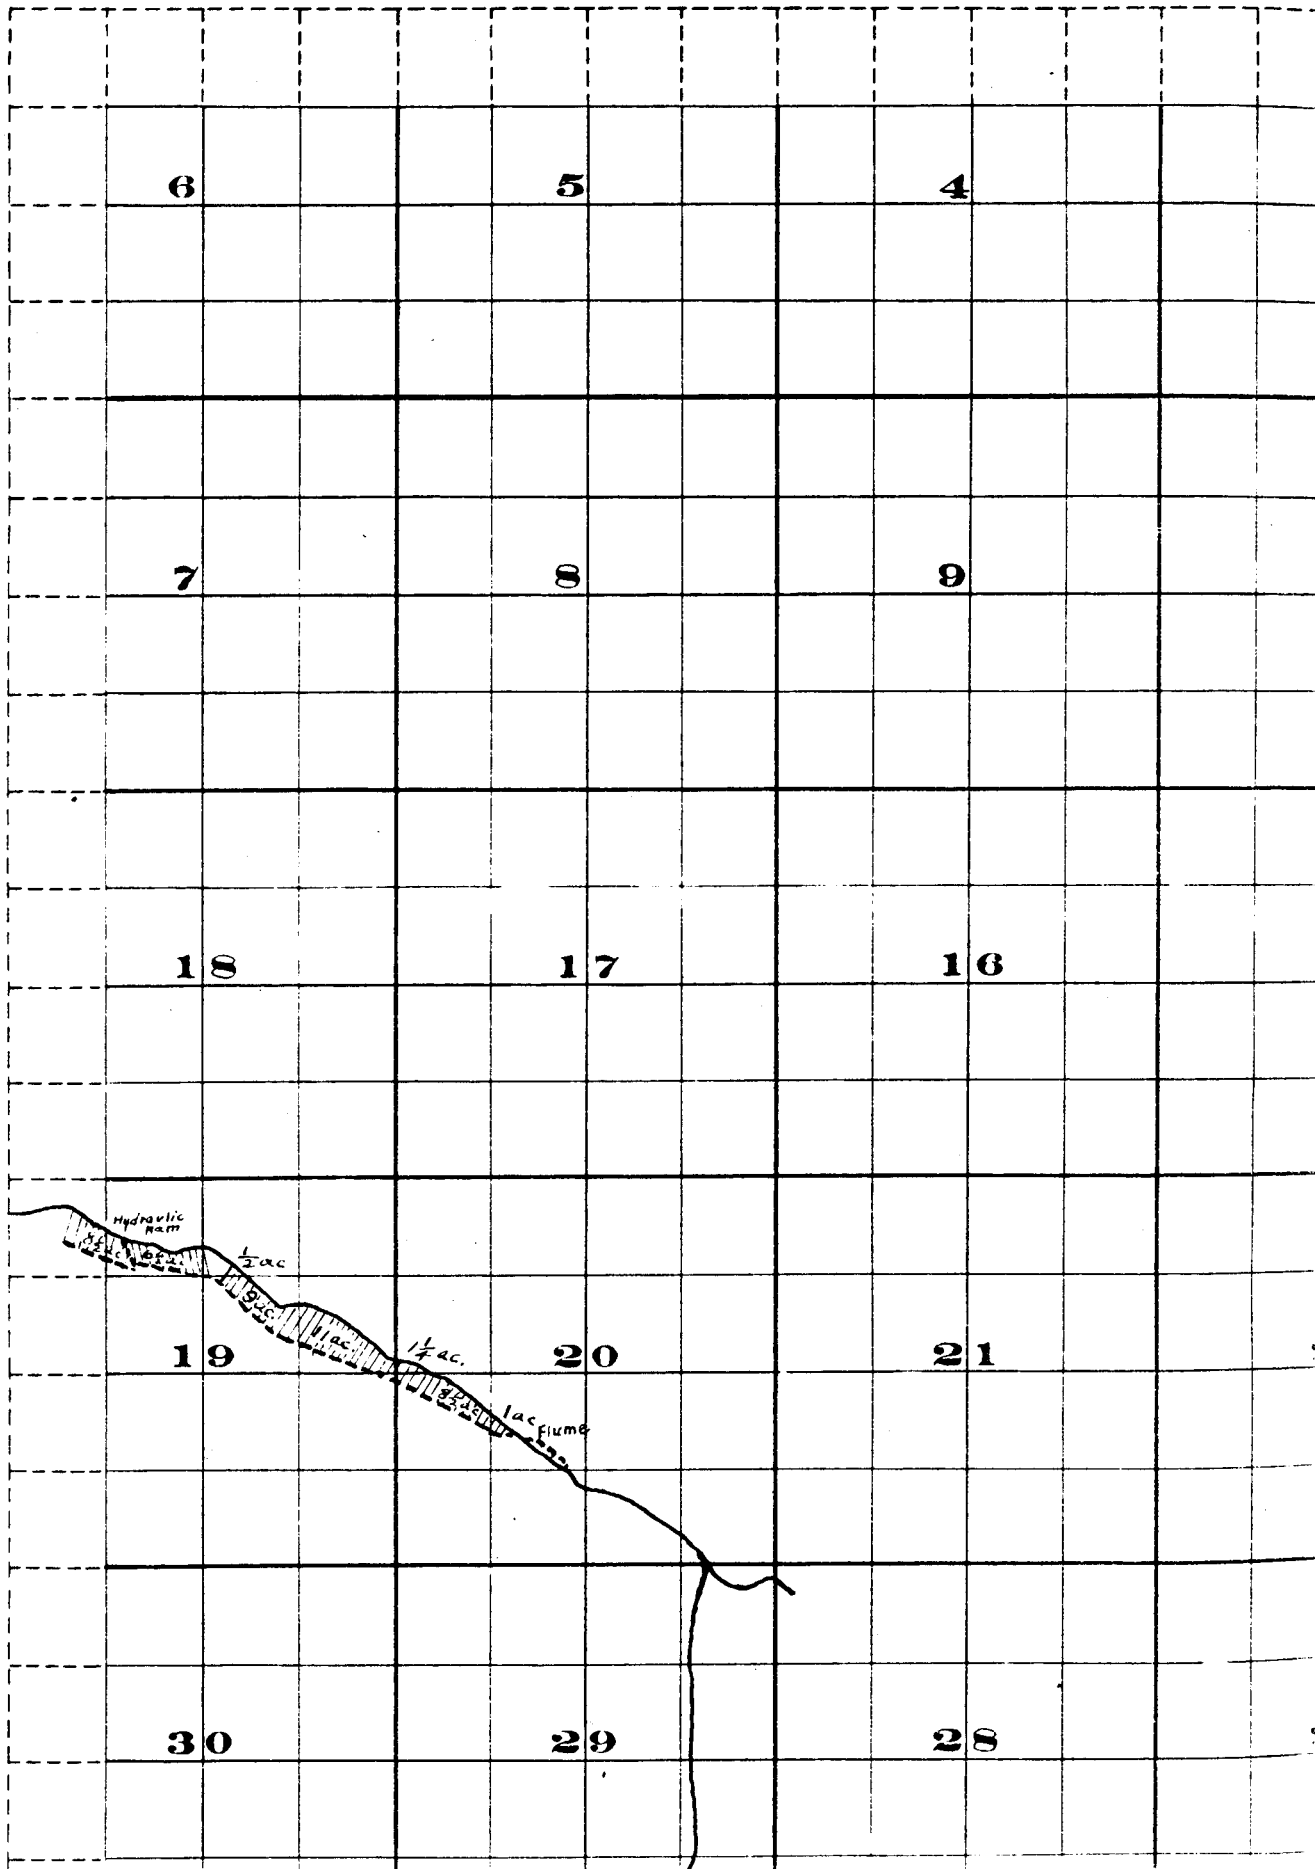

[illegible]