


T.13 S. R.31 E. W.M.

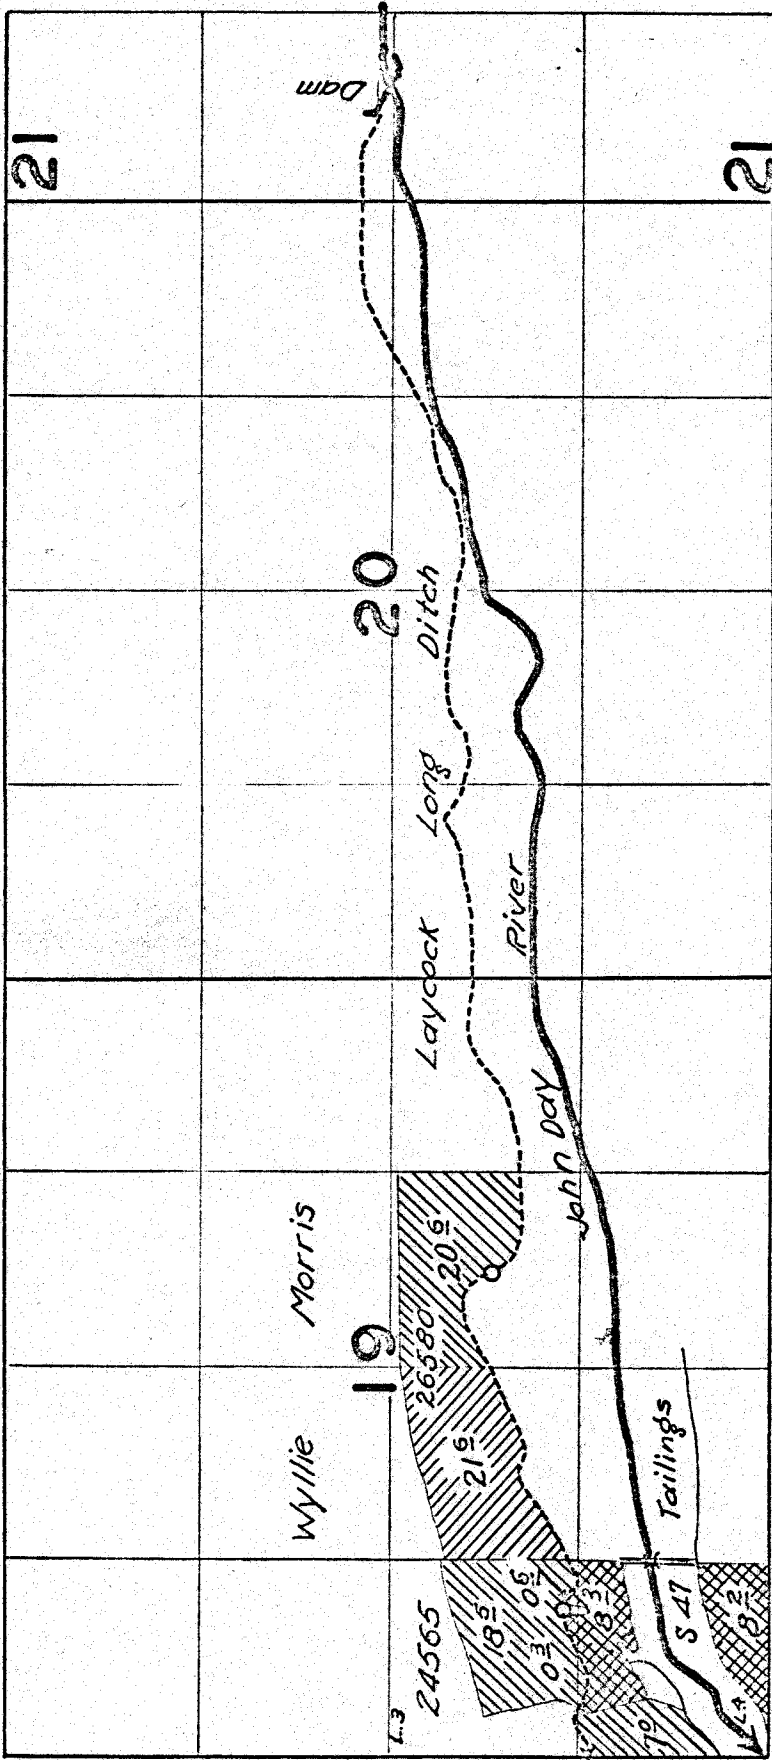

FINAL PROPOSED SURVEY

Application No. 26580 Permit No. 20824
 S-47 19567

Name: John Silvers & James A. Wyllie & Clark Morris
 Surveyed Aug. 27-28, 1954 by H. L. Coffman & T. Jones

06-28
 Pantograph

P-19367
 21407