


# T.IOS.RIW. WM

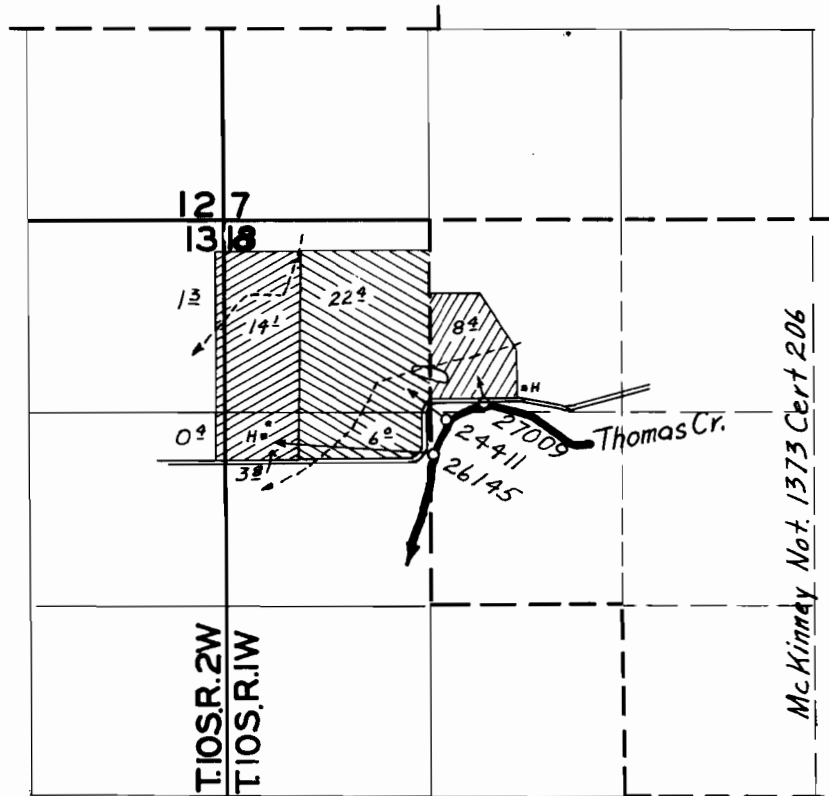

## FINAL PROOF SURVEY

27009                      21213  
 24411                      19453  
 Application No. 26145    Permit No. 20991

Hans Peterson  
 Ernest Scott, Jr.  
 Samuel J. Burdick

Surveyed July 8 19 54, by L. Coffman.