


7

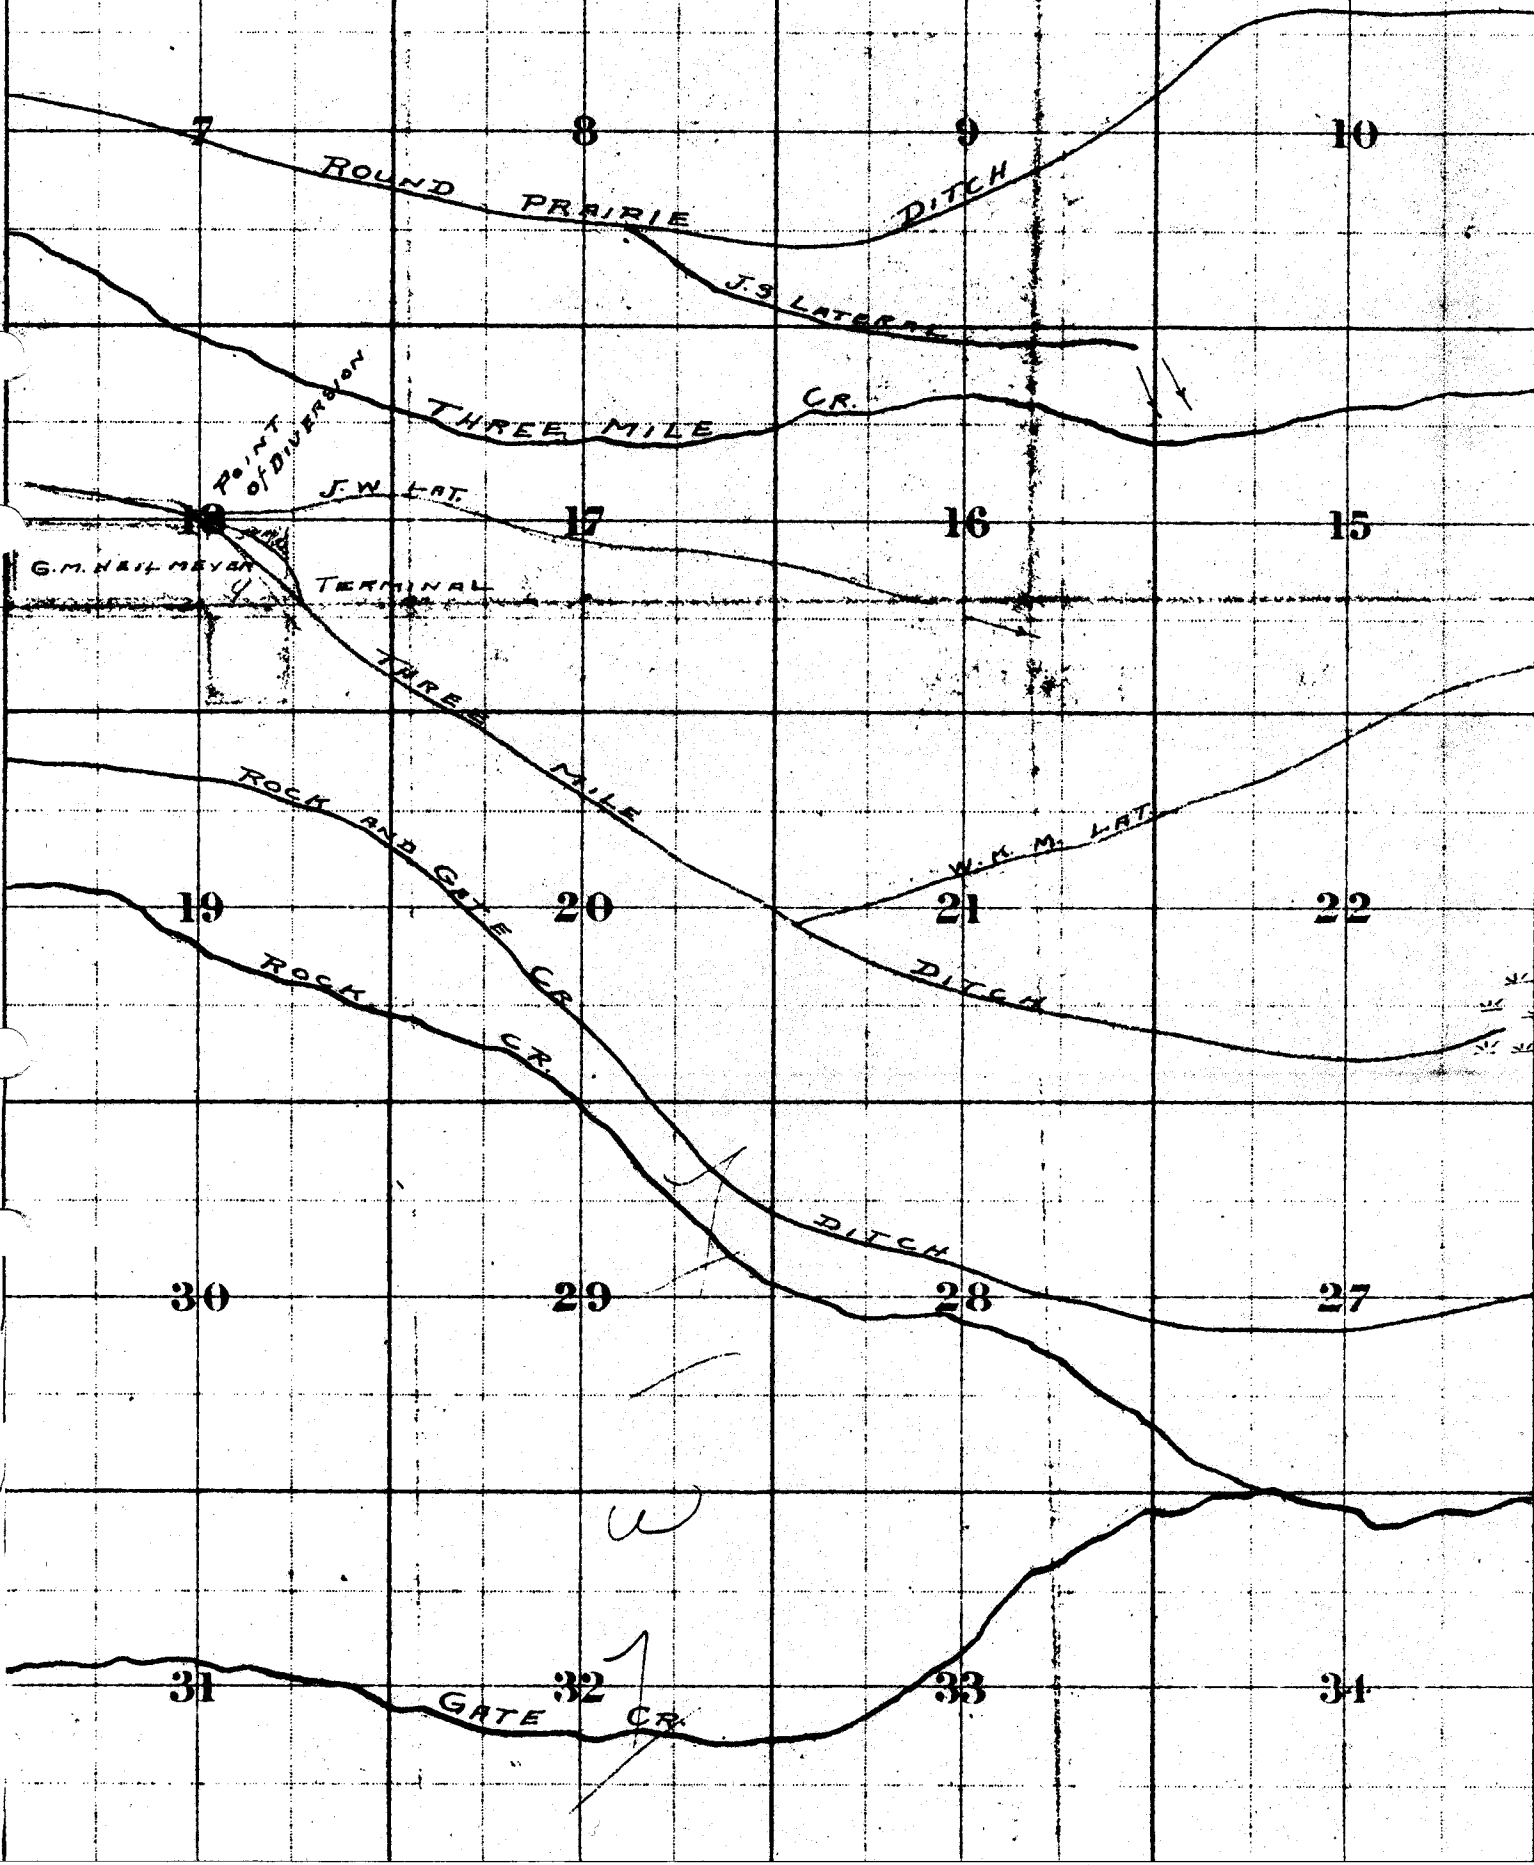

7

8

9

10

ROUND PRAIRIE DITCH

J.S. LATERAL

THREE MILE CR.

POINT OF DIVERSION

J.W. LAT.

17

16

15

G.M. NAIL MEYER

TERMINAL

THREE MILE

ROCK AND GALE CR.

W.R.M. LAT.

19

20

21

22

ROCK CR.

DITCH

DITCH

30

29

28

27

w

31

32

33

34

GATE CR.

7