


T.10S.R.2 W.WM

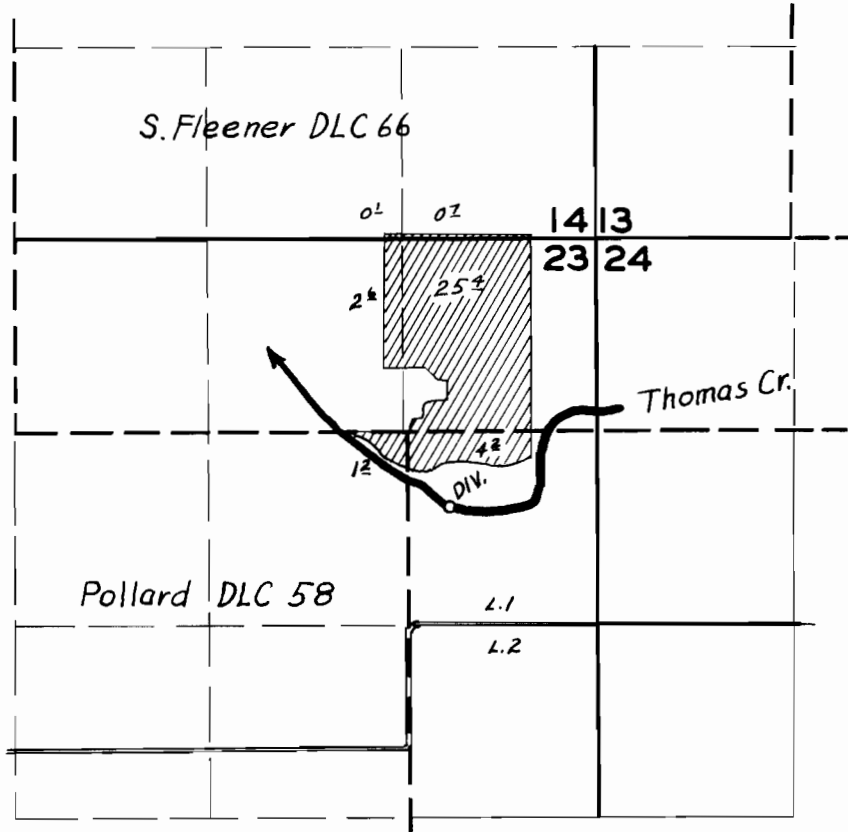

FINAL PROOF SURVEY

UNDER

Application No. 24869 Permit No. 19568
IN NAME OF

R. S. Thurston

Surveyed July 6 19 54, by H. L. Coffman.

DFM-2D-48