


T. 20 S., R. 331/2E W.M.

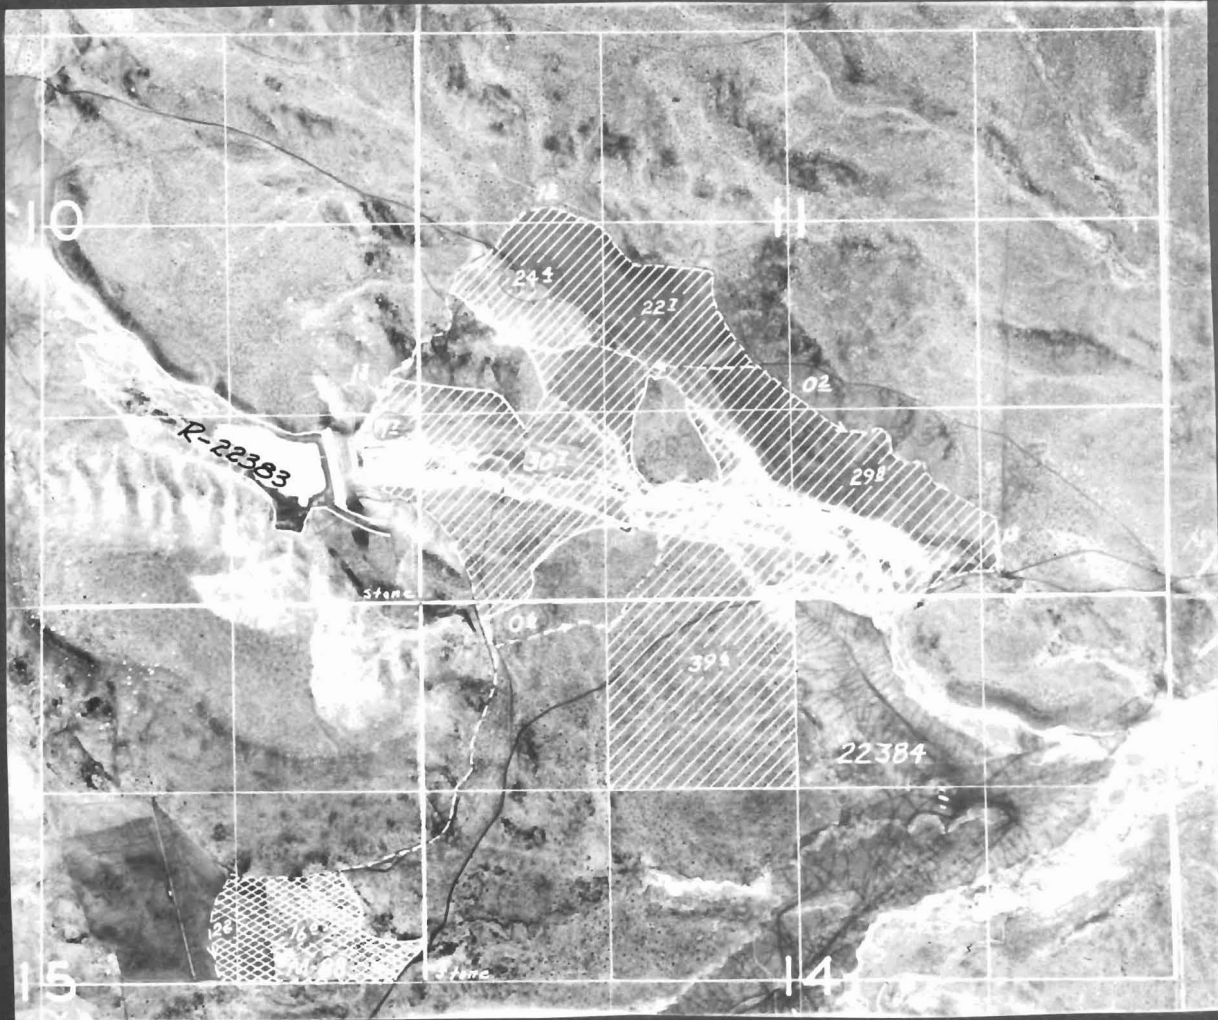

FINAL PROOF SURVEY

UNDER

Application No. R-22383 Permit No. M-88
22384 R-878
IN NAME OF

Francis and Rosetta Miller

Surveyed June 26 1954, by T. Jones

DGM-9-2