


T. 20 S., R. 331/2E W.M.

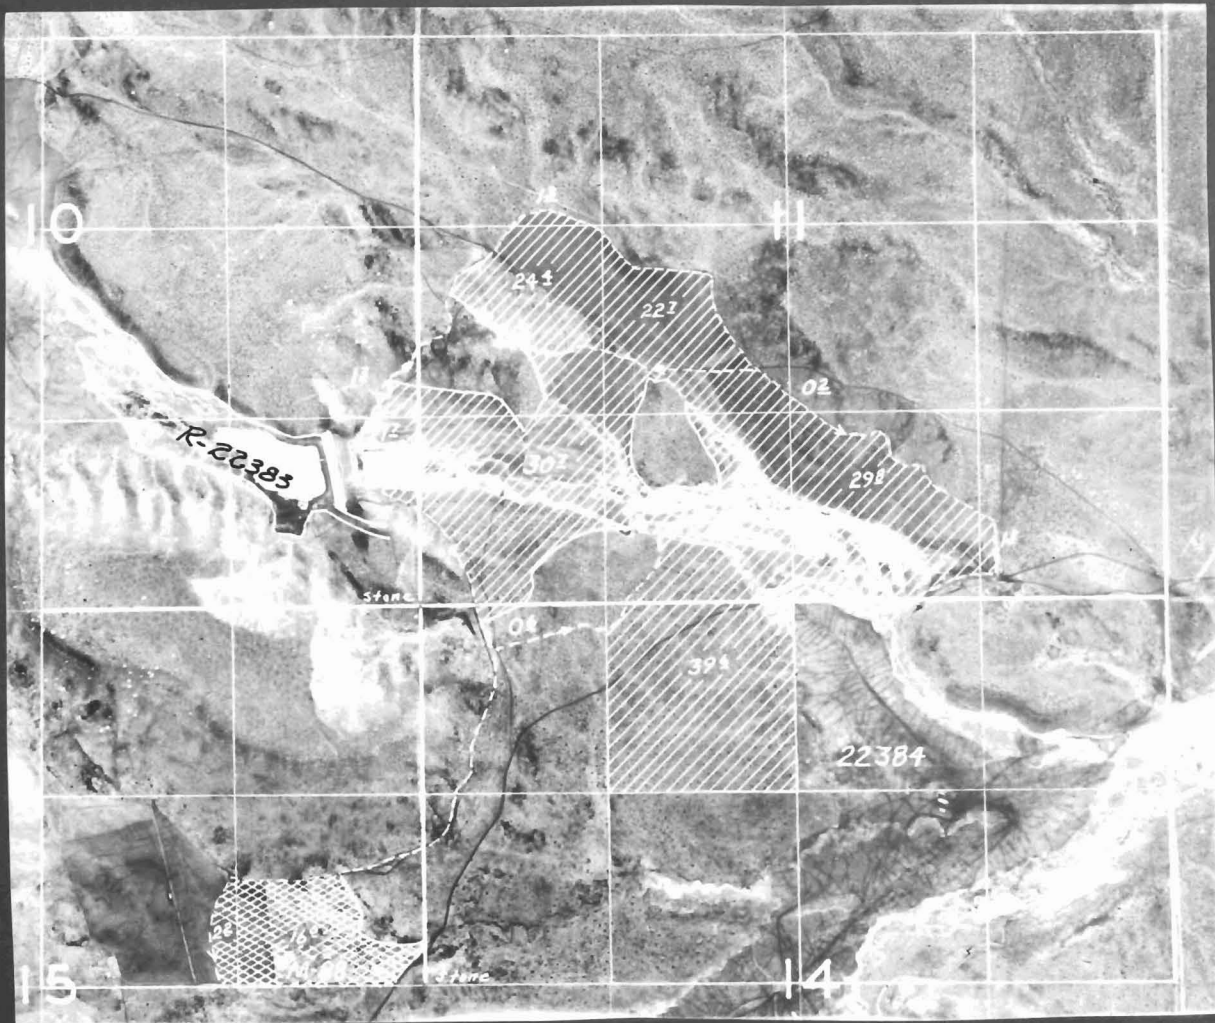

## FINAL PROOF SURVEY

UNDER

Application No. R-22383 <sup>M-88</sup>  
22384 <sup>R-878</sup> Permit No. 17701  
IN NAME OF

Francis and Rosetta Miller

Surveyed June 26, 1954, by T. Jones

DGW-9-2