


T3NR10W.W.M.

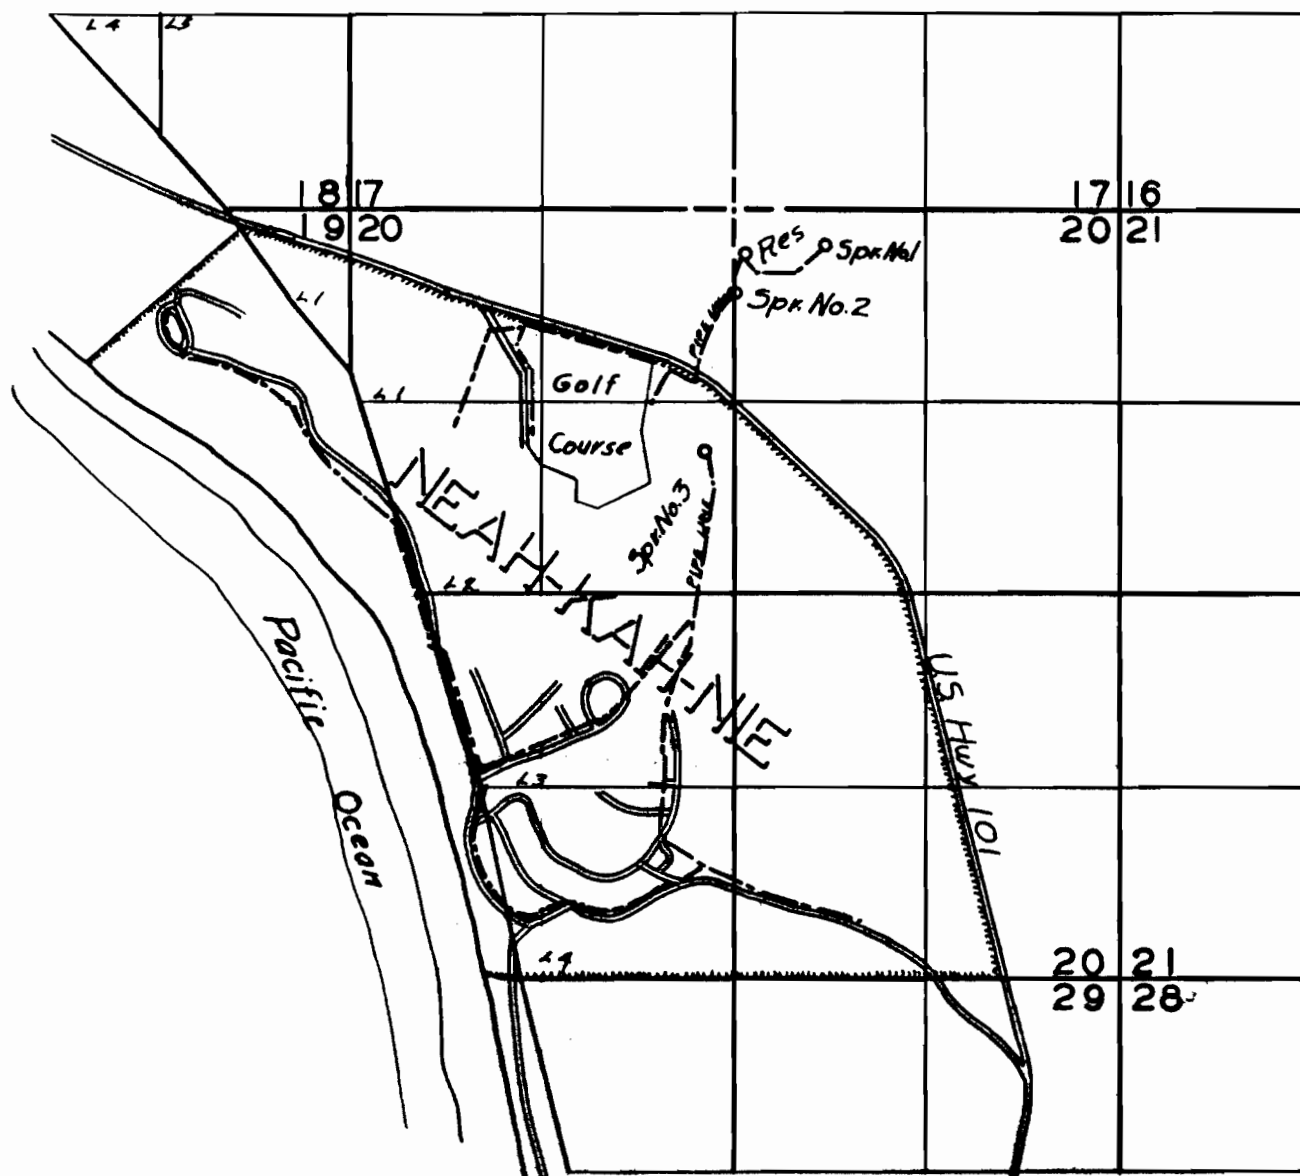

FINAL PROOF SURVEY
UNDER

Application No. 12602 Permit No. 10040
IN NAME OF

NEAH-KAH-NIE WATER COMPANY

Surveyed 3 August 1955, by Robert H. [Signature]

FILE COPY

T1-19-Pant