


T. 3 N. R. 2 W. W. M.

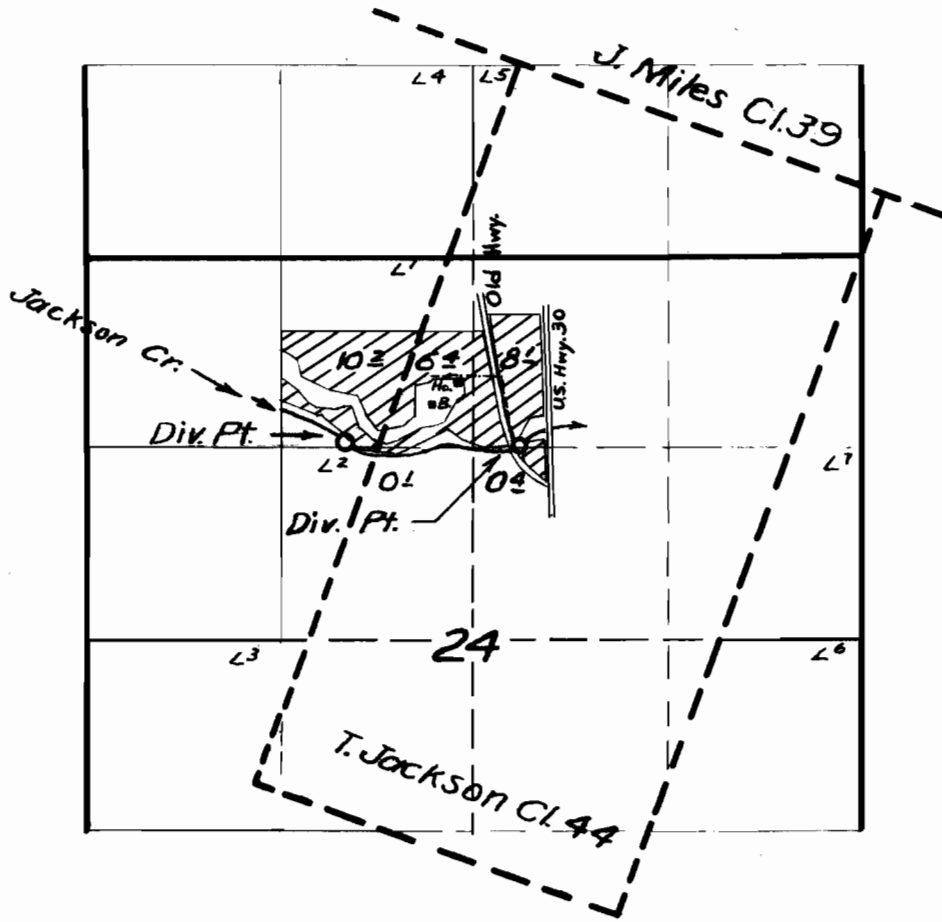

FINAL PROOF SURVEY

UNDER

Application No. 18082 Permit No. 13745

IN NAME OF

Wesley L. Brown & LeRoy Brown

Surveyed Sept 19 1955, by *M. Bish*