


T.4 S.R. 10 W.W.M.

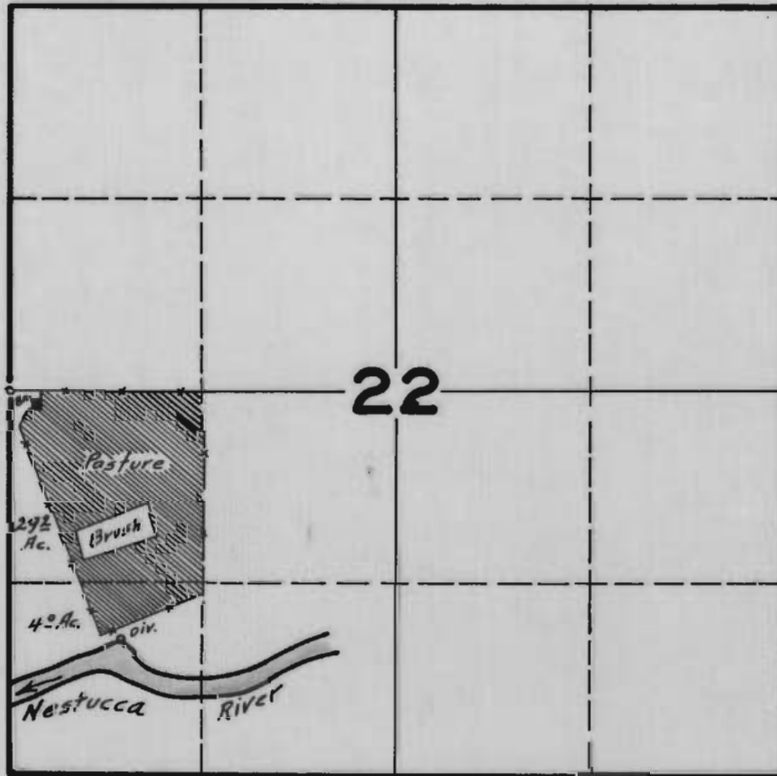

FINAL PROOF SURVEY

UNDER

Application No. 20377 Permit No. 15892

IN NAME OF

GUY YUNG

Surveyed JULY 19 1946, by J. E. Sumrell