


T.15S.R.42E.W.M.

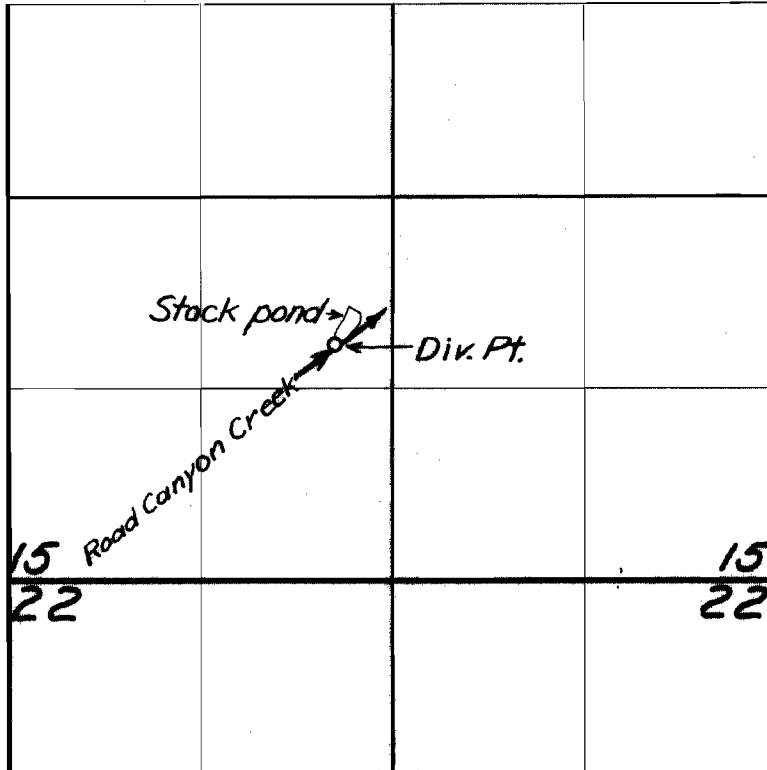

FINAL PROOF SURVEY

UNDER

Application No. 20822 Permit No. 16293.

IN NAME OF

JACK PEARSON

Surveyed Oct. 26 1955, by *M. Bish*