


T 6 S. R. 10 W. W. M.

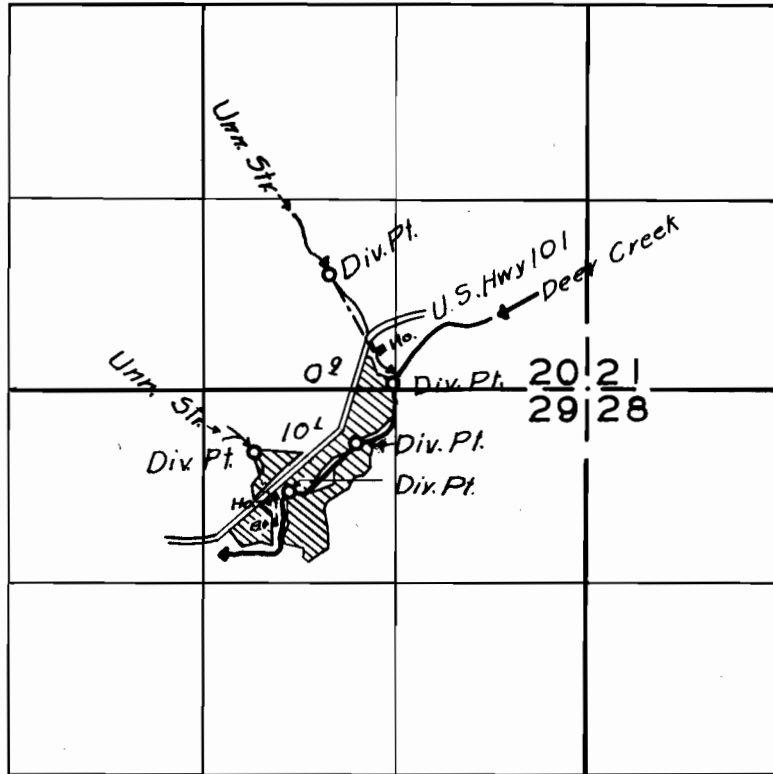

FINAL PROOF SURVEY
UNDER

Application No. 21125... Permit No. 16555...
IN NAME OF

GAYTON R. PHELPS

Surveyed 24 August 1955, by *Robert H. Reed*