


T8SR10WWM

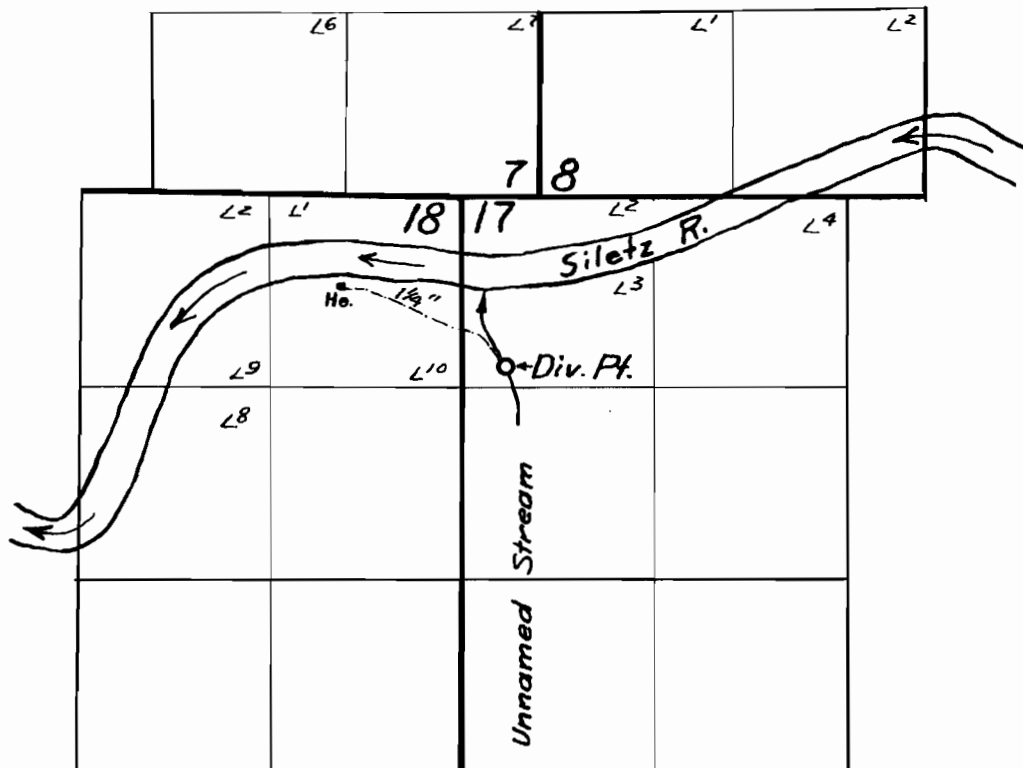

FINAL PROOF SURVEY

UNDER

Application No. 21147... Permit No. 16573...

IN NAME OF

HORACE M. BIBBY

Surveyed Sept. 2 1955, by *M. Bish*