


T3SR8#9WWM

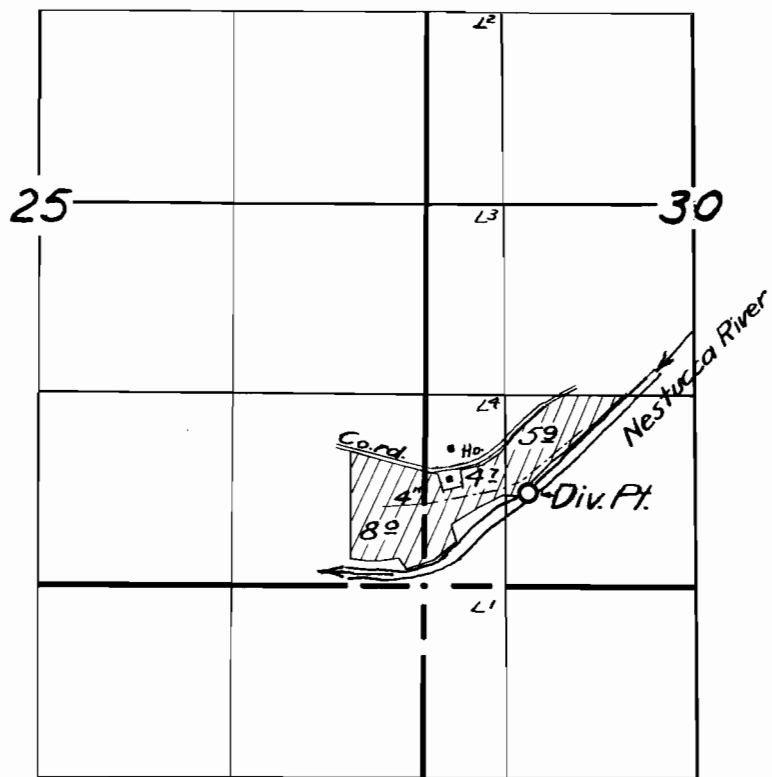

FINAL PROOF SURVEY
UNDER

Application No. *21523* Permit No. *16878*
IN NAME OF

IVAHL. BROWNING

Surveyed *Sept. 12 1955*, by *Tm. Bial*