


T7SRIIWWM

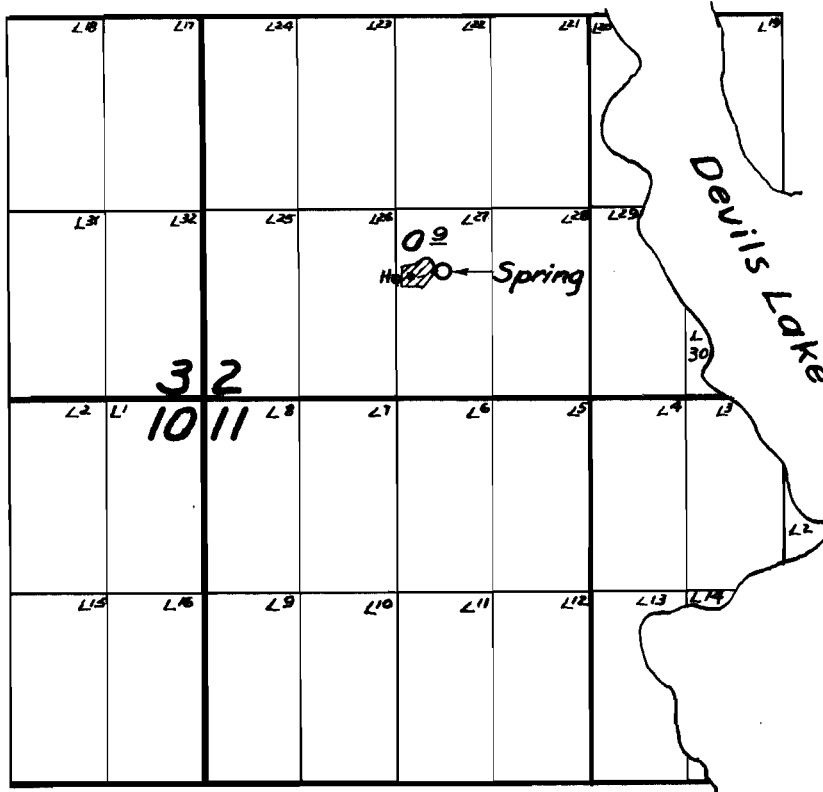

**FINAL PROOF SURVEY**  
UNDER

Application No. 21549 Permit No. 16896  
IN NAME OF

**J. D. ANDERSON**

Surveyed Aug 30 1955, by M. B. Bish