


1017

B. CRAM PIPELINE ²¹⁴⁴

P. 2418

Wasco & Crook Counties

Scale 2" = 1 Mile

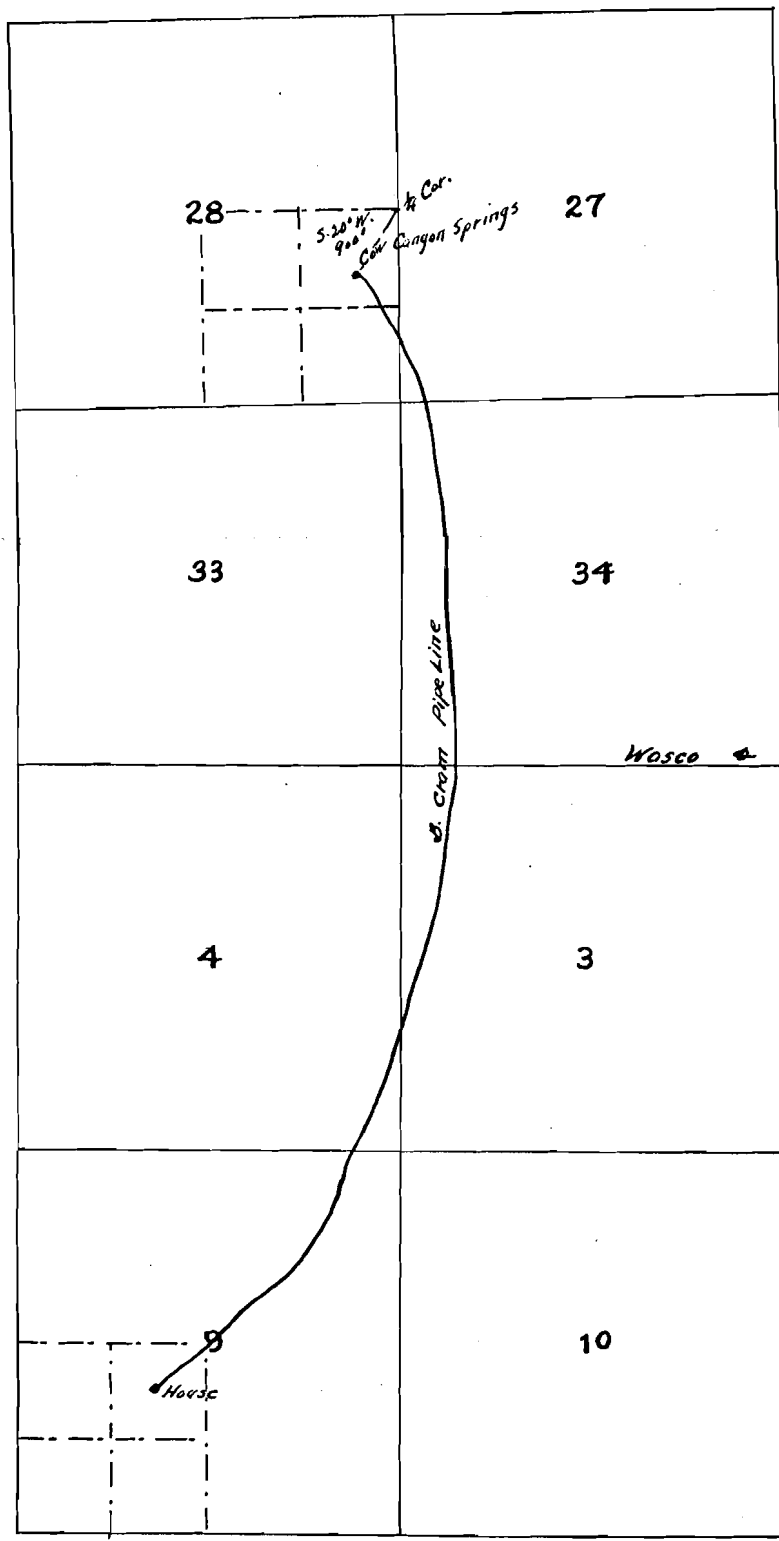

T. 8 S. R. 15 E.

Application No. 4151
Permit No.

Wasco & Crook Co. Line

T. 9 S. R. 15 E.

2418