


T28SR14WWM

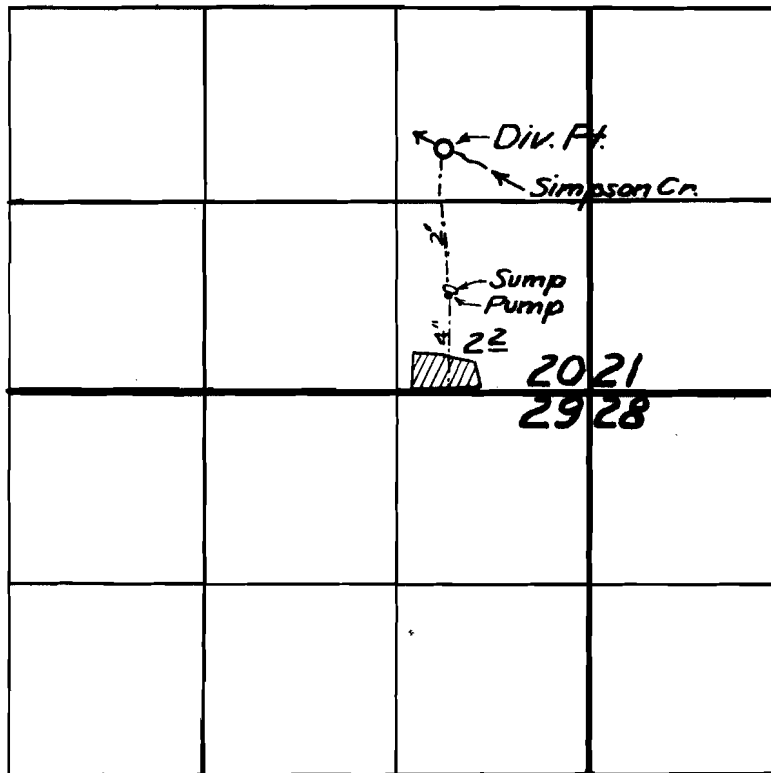

FINAL PROOF SURVEY

UNDER

Application No. 22245 Permit No. 17546

IN NAME OF

Raymond H. Smith

Surveyed Aug 20 1955, by M. Bish