


T28S R14WWM

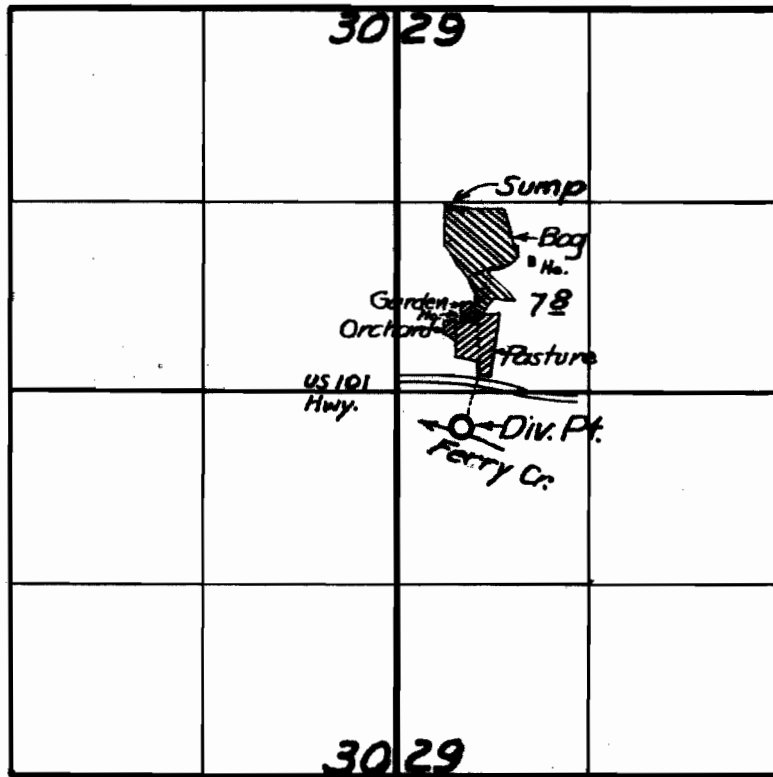

 HUTCHENS 5 $\frac{1}{2}$ Ac.
 ROSENBLAD 2 $\frac{1}{2}$ Ac.

FINAL PROOF SURVEY
UNDER

Application No. 21915 Permit No. 17380
IN NAME OF

K. Rosenblad & Alice S. Hutchens

Surveyed Aug 1942 9.55 by M. B. Bish