


T29SR12WWM

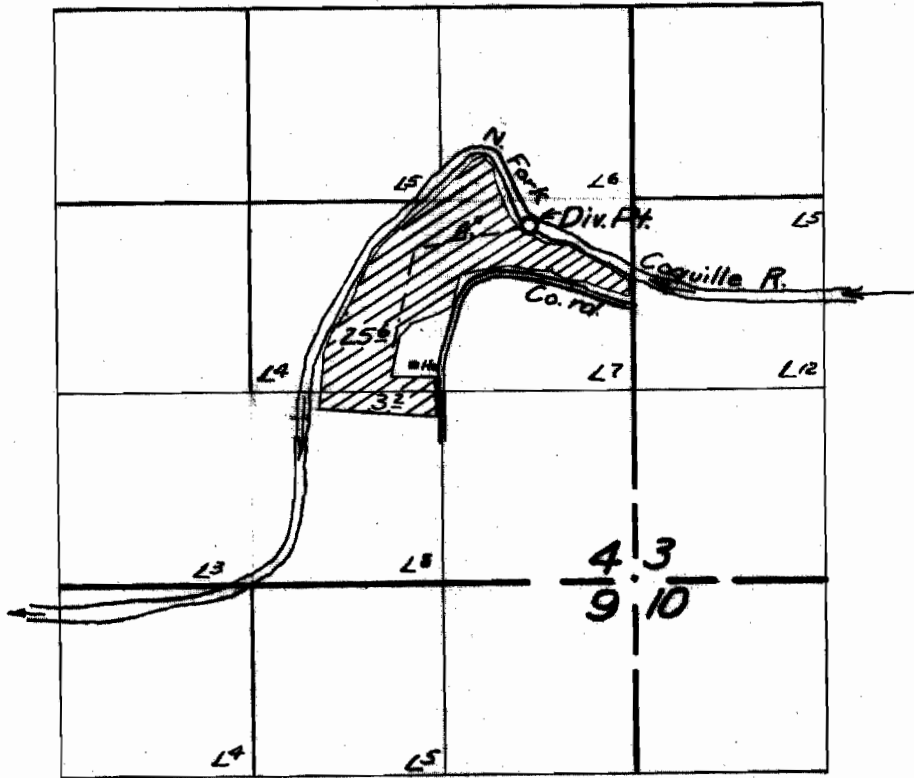

**FINAL PROOF SURVEY**

UNDER

Application No. 22656 Permit No. 17802

IN NAME OF

JOHN C. CAUDLE

Surveyed Aug 23 1955, by M. B. Boh