


T. 2 S. R. 9 W. W. M.

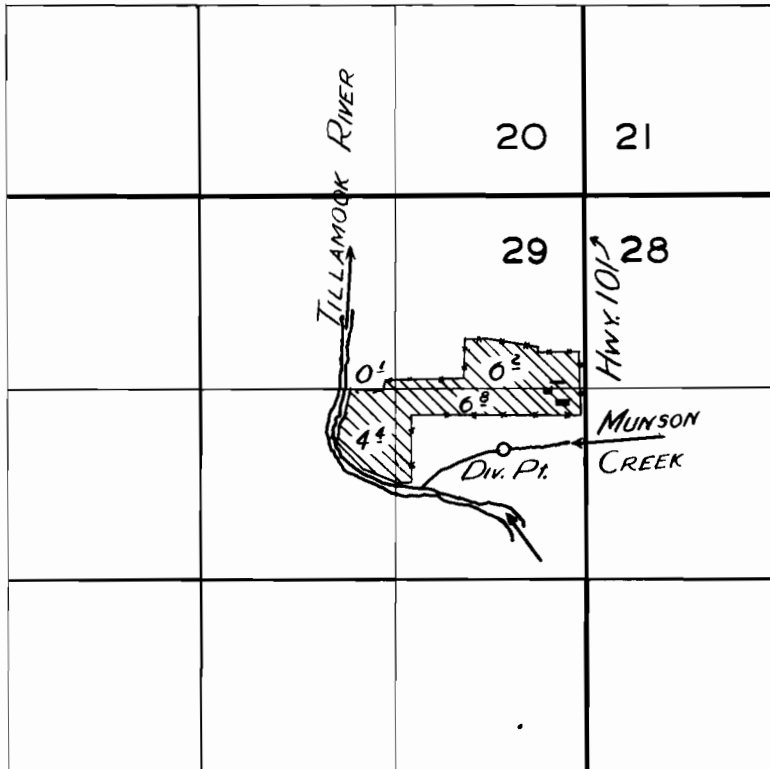

FINAL PROOF SURVEY

UNDER

Application No. 22626 Permit No. 17828

IN NAME OF

SCHUYLER L. FLETCHER

Surveyed 9 AUG 1955

by *[Signature]*