


T. 17 S., R. 1 W., W.M.

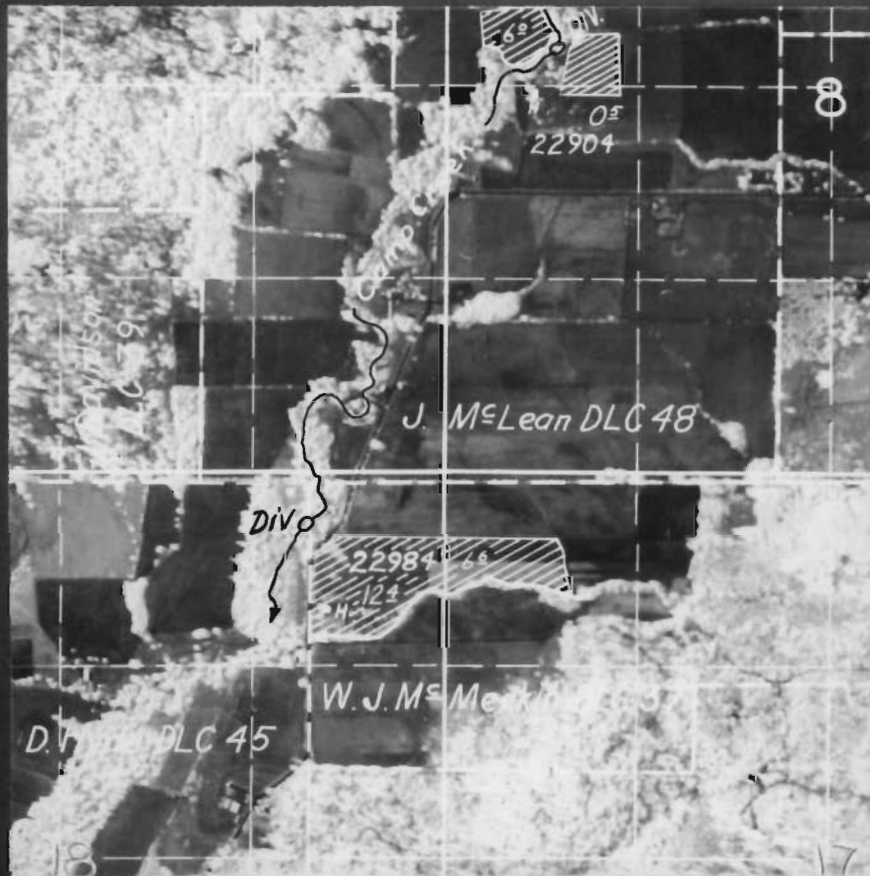

FINAL PROOF SURVEY

UNDER

22984

18097

Application No. 22901 Permit No. 18002

IN NAME OF

George Fisher

Warren Harding Cornelius

Surveyed May 3, 1954, by T. Jones

April 23, 1954

DBQ-5H-70