


T. 2 S. R. 9 W. W. M.

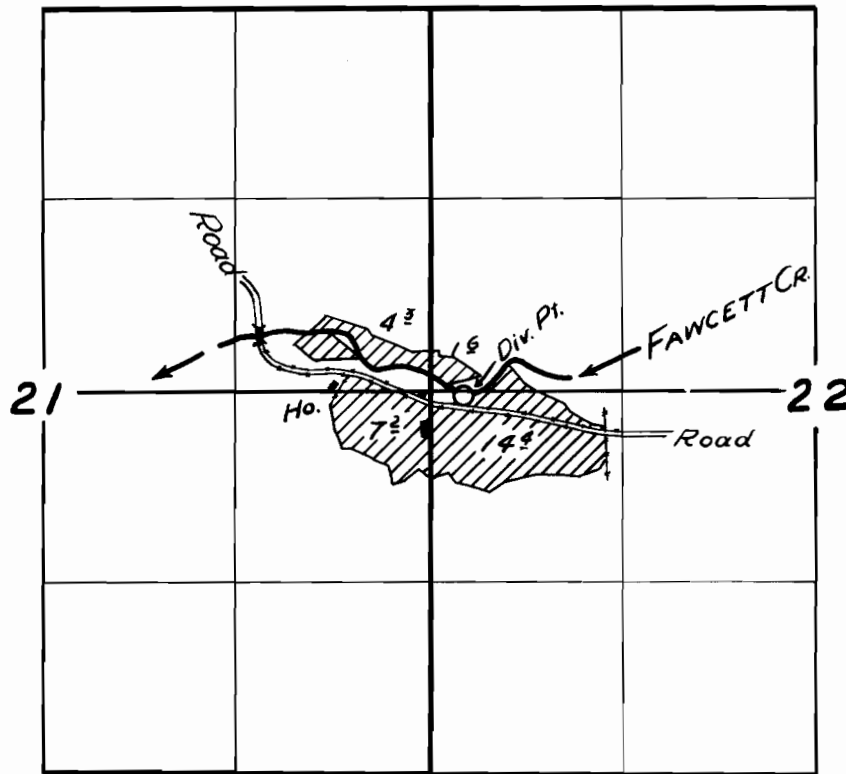

FINAL PROOF SURVEY
UNDER

Application No. 22691 Permit No. 18024
IN NAME OF

O. E. EFFENBERGER

Surveyed 7 Sep. 1955, by *Whitby*